

- copy -

MAY - 1 1995 LAND CORNER RECORDATION CERTIFICATE Filing Requirement of Act 74, Mich. P.A. 1970 COMMISSION

For corners in Washtenaw (County) Located In: Corner Code # 1. Public Land Survey T 4S R 3E L-11 2. Property Controlling in Section S T R 3. Miscellaneous Property in Sec. S T R 4. Lot No. Recorded Plat 5. Private Claims

RECORDED WASHTEENAW COUNTY, MI Dec 1 11 39 AM '94 PEGGY M. HAINES COUNTY CLERK/REGISTRAR -COPY-

Register of Deeds Stamp & File Number

I, Patrick L. Hastings in a field survey on October 7, 1994 do hereby certify that under requirements of P.A. 74, Michigan P.A. of 1970, the corner points mentioned in lines 1 and 2 above were in conformance with regulations and rules therefore as required in the current manual of survey instructions of the United States Department of the Interior, Bureau of Land Management or by a decree of a Court of Law and/or that the corner points mentioned in lines 3, 4 and 5 above were in conformance with the rules of the Michigan Board of Land Surveyors or by a Decree of a Court of Law; established, re-established, monumented, re-monumented, recovered, found as expressed below:

Grid table with columns A-M and rows 2-13. A dot is present in cell J11.

NOTE: Not more than 4 corners, all in the same town and range, may be recorded on this certificate.

A. Description of original monument and accessories and/or subsequent restoration:

- 1815 Township Boundary Set Post, Dep. Surveyor Hough (1) Basswood 28" N 50° E .81 lks (2) Basswood 10" S 50° W 0.37 lks 1816 Subdivision of Township 1824 Township GLO Plat by John M. Mack

CONTINUED ON BACK


B. Description of corner evidence found and/or method applied in restoring or reestablishing corner:

- 1994 Found a very rusty 1" x 1'-10" iron pipe top bent slightly to the North. Dug to where pipe went straight. Checked witness. Dug to depth of 2', no brick or stone. Road gravel 1'-8" deep. Iron pipe is on centerline of road to west and on centerline N & S. (4) East 26.87' 12" Walnut stump (6) S 23° E 69.3' 18" Walnut to 2" deep blaze (9) S 34° E 50.13' 22" Ash stump (10) S 42° E 32.40' Pole marking Ma Bell box, poor condition (10) S 43° E 31.40' Pole marking Ma Bell box, now stump (7) N 19° W 86.11' 16" Hickory to Pd Nail (7) N 19° W 86.4' 16" Hickory to Side Center (11) S 75° W 119.82' Telephone Pole to Pd. Nail & Shiner

C. Description of monument for corner and accessories established to perpetuate locating the position of the corner:

After a careful study of the record documentation and field observations, made under my direct supervision, I find this corner as remonumented to be the best available evidence of the position of the original corner.

CONTINUED ON BACK

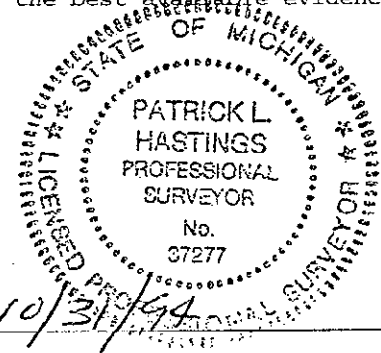

Signed by Patrick L. Hastings Date 10/31/94 Surveyor's Michigan License No. 37277

1

SECTION 'A' CONTINUED

No Date	W.C.R.C. Grid Book, Handwritten Notes		
	(3)	N 25° E	79.81' 18" Walnut
	(4)	East	26.53' 9" Walnut
	(5)	S 34° E	39.94' 11" Ash
	(6)	S 23° E	69.88' 17" Walnut
	(7)	N 19° W	86.78' 10" Hickory
	(8)	N 37° E	48.06' 3" Twin Elm
No Date	By A-H. Inc. Drawing. Compilation of records		
	(1)	Basswood 28" N 50° E	.81 lks
	(2)	Basswood 10" S 50° W	.37 lks
1966	From Associated Engineers & Surveyors, Adrian Field Notes, found iron		
	(4)	East	26.65' 10" Walnut Spk. & MSHD Tag
	(9)	S.E.	50.1' 18" Tree Spk. & MSHD Tag
1977	Survey by Kenneth L. Sydam		
	(4)	East	26.35' 16" Walnut
	(9)	S 40° E	50.25' 30" Ash
	(10)	S 45° E	31.75' T.P.
1978	L.C.R.C. by Kenneth L. Sydam		
	(4)	East	26.35' 16" Walnut Nail & Shrne
	(9)	S 40° E	50.25' 30" Ash
	(10)	S 45° E	31.75' T.P.
1984	Survey by Kenneth L. Sydam, Found 1 1/4" I.P.		
	(4)	East	26.42' 16" Walnut
	(7)	N 20° W	86.34' 16" Hickory
	(10)	S 50° E	31.90' Pole Marking Box
	(11)	S 75° W	119.80' Elec. Pole

SECTION 'C' CONTINUED

Set 1" x 24" iron pipe and remonumentation cap stamped #37277 7" below surface and surrounded with stone.

(6)	S 23° E	69.55'	18" Walnut	RT & PK
(7)	N 19° W	86.11'	16" Hickory	RT & PK
(11)	S 75° W	119.82'	Tele. Pole	RT & PK
(12)	S 35° E	48.44'	8" Ash	RT & PK
(13)	N 15° E	80.74'	10" Ash	RT & PK

APPROVED

DATE 10/31/94CO. REP. KA