

MAY - 1 1995

COPY

LIBER

- Copy -

LAND CORNER RECORDATION CERTIFICATE
COMMISSION Filing Requirement of Act 74, Mich. P.A. 1970

For corners in

Washtenaw (County)	Located In:	Corner Code #
1. Public Land Survey	T 4S R 3E	L-13
	T R	
	T R	
	T R	
2. Property Controlling in Section	S T R	
	S T R	
3. Miscellaneous Property in Sec.	S T R	
	S T R	

LIBER
 PEGGY M. HAINES
 COUNTY CLERK/REGISTER
 - Copy -
 Dec 1 11 39 AM '94
 RECORDED
 WASHTENAW COUNTY, MI

Register of Deeds Stamp & File Number

- 4. Lot No. _____, Recorded Plat _____
- 5. Private Claims _____

A	B	C	D	E	F	G	H	I	J	K	L	M
2	6	5	4	3	2	1						
3												
4	7	8	9	10	11	12						
5												
6	16	17	16	15	14	13						
7												
8	19	20	21	22	23	24						
9												
10	30	29	28	27	26	25						
11												
12	31	32	33	34	35	36						
13												

I, Patrick L. Hastings a field survey on October 7, 19 94, do hereby certify that under requirements of P.A. 74, Michigan P.A. of 1970, the corner points mentioned in lines 1 and 2 above were in conformance with regulations and rules therefore as required in the current manual of survey instructions of the United States Department of the Interior, Bureau of Land Management or by a decree of a Court of Law and/or that the corner points mentioned in lines 3, 4 and 5 above were in conformance with the rules of the Michigan Board of Land Surveyors or by a Decree of a Court of Law; established, re-established, monumented, re-monumented, recovered, found as expressed below:

NOTE: Not more than 4 corners, all in the same town and range, may be recorded on this certificate.

A. Description of original monument and accessories and/or subsequent restoration:

- 1815 Township Boundary Set Post, Dep. Surveyor Hough
 (1) W. Oak - 6" N 61° E 22 lks
 (2) Oak - 16" N 3° W 42 lks
- 1816 Subdivision of Township
- 1824 Township GLO Plat by John M. Mack
- 1933 W.C.R.C. Grid Book by W.J. Armstrong. Found old wood stake. Reset with 1 1/2" x 42" iron pipe and placed 4 bricks around it.

CONTINUED ON BACK


B. Description of corner evidence found and/or method applied in restoring or reestablishing corner:

- 1994 Found 1 1/4" iron pipe 2" below surface surrounded with brick at 6" below surface, below brick found stones. Occupation line to west, occupational fence line to east.
 (3) S 88 1/2° W 32.88' 32" Hickory to nail and shinner
 (5) S 23° E 55.2' Center of hole from a 36" dead elm, fell over
 (8) S 88° W 52.8' 20" Hickory
 (9) S 88° W 80.2' 32" Pignut Hickory (not maple)
 (12) N 80° E 29.83' 14" Hickory to nail and shinner

C. Description of monument for corner and accessories established to perpetuate locating the position of the corner:

After a careful study of the record documentation and field observations, made under my direct supervision, I find this corner to be a careful and faithful perpetuation of the position of the original corner.

CONTINUED ON BACK

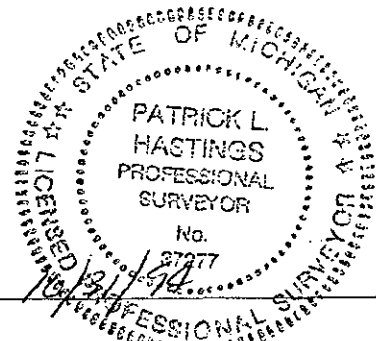

Signed by Patrick L. Hastings Date _____
 Surveyor's Michigan License No. 37277

- Copy -

SECTION 'A' CONTINUED

1933 W.C.R.C.
 Typed
 (3) S 88 1/2° W 33.25' 30" Hickory
 (4) S 85° E 45.15' 6" Elm
 (5) S 23° E 55.2' 12" Elm
 (6) S 17° W 78.1' 3" Twin Hickory
 Handwritten
 (5) S 23° E 55.20' 32" Elm
 (7) S 80° W 32.65' 28" Hickory
 (8) S 80° W 52.43' 16" Hickory
 (9) S 88° E 80.05' 24" Maple
 (10) S 85° E 50.13' 18" Elm
 (11) N 84° E 45.11' 16" Elm
 (12) N 77° E 30.14' 9" Hickory

No Date by A-H, Inc., Drawing, Compilation of records.
 (3) S 88 1/2° W 33.25' 30" Hickory
 (4) S 85° E 45.15' 6" Elm
 (5) S 23° E 55.2' 12" Elm
 (6) S 17° W 78.1' 3" Twin Hickory

1966 Field notes from Associated Engineers & Surveyors, Adrian, corner recovered, found iron, all to witnesses.

1984 Survey by Kenneth L. Suydan, found 1-1/4" iron pipe
 (3) West 32.95' 32" Hickory
 (12) N 80° E 29.80' 12" Hickory
 (13) S 65° E 33.85' Telephone Pole

SECTION 'C' CONTINUED

Set a 3/4" x 9" iron pipe inside the 1 1/4" iron with standard remon. cap stamped #37277, 8" below surface surrounded with brick and stone.

(3)	S 88 1/2° W	32.88'	32" Hickory	RT & PK
(9)	S 88° E	80.16'	32" Pignut Hickory	RT & PK
(12)	N 80° E	29.83'	14" Hickory	RT & PK
(13)	S 08° E	101.96'	4" Hickory	RT & PK
(14)	S 65° W	100.27'	N.E. Cor. House Foundation Wall	

APPROVED

DATE 10/31/94CO. REP. KA