

COPY

MAY - 1 1995

LAND CORNER RECORDATION CERTIFICATE

Filing Requirement of Act 74, Mich. P.A. 1970

For corners in

COMMISSION

Washtenaw (County)

Located In:

Corner Code ##

1. Public Land Survey	T	4S	R	3E	M-9
	T		R		
	T		R		
	T		R		
2. Property Controlling in Section	S		T	R	
	S		T	R	
3. Miscellaneous Property in Sec.	S		T	R	
	S		T	R	

COPY - PEGGY M. HAINES COUNTY CLERK/REGISTER

DEC 1 11 40 AM '94

RECORDED WASHTEENAW COUNTY, MI

Register of Deeds Stamp & File Number

- 4. Lot No. \_\_\_\_\_, Recorded Plat \_\_\_\_\_
- 5. Private Claims \_\_\_\_\_

I, Patrick L. Hastings in a field survey on October 7, 1994, do hereby certify that under requirements of P.A. 74, Michigan P.A. of 1970, the corner points mentioned in lines 1 and 2 above were in conformance with regulations and rules therefore as required in the current manual of survey instructions of the United States Department of the Interior, Bureau of Land Management or by a decree of a Court of Law and/or that the corner points mentioned in lines 3, 4 and 5 above were in conformance with the rules of the Michigan Board of Land Surveyors or by a Decree of a Court of Law; established, re-established, monumented, re-monumented, recovered, found as expressed below:

**NOTE: Not more than 4 corners, all in the same town and range, may be recorded on this certificate.**

A	B	C	D	E	F	G	H	I	J	K	L	M
2	6	5	4	3	2	1						
3												
4	7	8	9	10	11	12						
5												
6	18	17	16	15	14	13						
7												
8	19	20	21	22	23	24						
9												
10	30	29	28	27	26	25						
11												
12	31	32	33	34	35	36						
13												

A. Description of original monument and accessories and/or subsequent restoration:

- 1815 Township Boundary, Set Post, Dep. Surveyor Hough  
(1) B. Oak - 16" S 46° E 19 lks  
(2) Oak - 16" S 19° W 23 lks
- 1816 Subdivision of Township, Field Notes
- 1824 G.L.O. Plat by John M. Mack
- 1934 W.C.R.C. Grid book, by W.J. Armstrong. Reset this post from government notes (see field notes) with a 1" x 36" iron pipe with stones and bricks around it.

CONTINUED ON BACK


B. Description of corner evidence found and/or method applied in restoring or reestablishing corner:

- 1994 Found a bent 1/2" x 9" iron pipe and unreadable cap over a broken plow point and horse shoe and a circle of stone and brick very well defined where Armstrong pipe was set. Accepted this location. Located along centerline of road N-S and West.  
(5) N 73° E 42.4' N.W. Cor. Shed  
(6) S 85 1/2° E 39.7' S.W. Cor. Shed  
(9) S 16° W 104.3' 30" W. Oak  
(10) S 81 1/2° W 126.4' 18" W. Oak  
(11) N 25° W 42.00' S.E. Cor. Ret. Wall

C. Description of monument for corner and accessories established to perpetuate locating the position of the corner:

After a careful study of the record documentation and field observations, made under my direct supervision, I find this monument is a careful and faithful reestablishment of the position of the original corner.

CONTINUED ON BACK

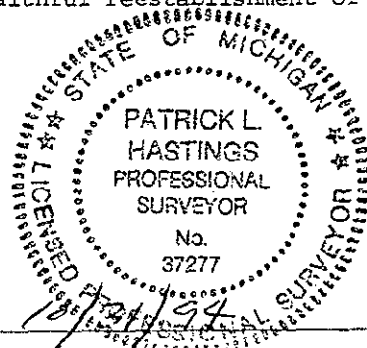

signed by Patrick L. Hastings Date 10/7/94  
 Surveyor's Michigan License No. 37277

1

LIBER

1 PAGE 216 Rm  
- Copy -

SECTION 'A' CONTINUED

1934 W.C.R.C

Typed

(3)	N 11° E	88.7'	6" Walnut
(4)	N 11° E	78.6'	6" Walnut
(5)	N 73° E	42.4'	N.W. Cor. Shed
(6)	S 85 1/2° E	39.7'	S.W. Cor. Shed
(7)	S 57° E	14.8'	26" W. Oak
(8)	S 17° E	59.3'	12" W. Oak
(9)	S 16° W	104.3'	30" W. Oak
(10)	S 81 1/2° W	126.4'	12" W. Oak
Handwritten (No Date)			
(9)	S 16° W	103.86'	26" W. Oak
(10)	S 81° W	126.4'	18" W. Oak
(11)	N 25° W	42.00'	S.E. Cor. Ret. Wall

1942 W.C.R.C. Grid Book Plat by W.J. Armstrong

West	2730.0'	N 1/4 Cor. of Section
South	2671.0'	E 1/4 Cor. of Section

1974 From Associated Engineers & Surveyors, Adrian, MI

(12)	S 12° E	64.75'	32" Oak	Nail & disc W. Side
(13)	S 23° W	37.24'	15" Catalpa	Nail & disc. E. Side
(14)	N 80° W	69.24'	20" Walnut	S.C.S. BM tag in S. Side
(15)	N 09° W	64.03'	42" Oak	Nail & disc E. Side

SECTION 'C' CONTINUED

Set 1" x 24" iron pipe and remon. cap stamped #37277 in the circle of stone an brick as set around pipe set by Armstrong in 1932.

(5)	N 73° E	42.12'	N.W. Cor. Shed
(6)	S 85 1/2° E	39.62'	S.W. Cor. Shed
(9)	S 16° W	104.28'	30" W. Oak RT & PK
(10)	S 81 1/2° W	126.16'	12" W. Oak RT & PK
(11)	N 25° W	42.0'±	S.E. Cor. retaining wall broke off
(12)	S 12° E	64.75'	N.E. Cor. barn foundation
(16)	West	0.50'	Buried Tele. Cable, E & W

APPROVED

DATE 10/31/94

CO. REP. K

7