

MAY - 1 1995

LAND CORNER RECORDATION CERTIFICATE Filing Requirement of Act 74, Mich. P.A. 1970

For corners in

COMMISSION

Washtenaw (County)

Located In:

Corner Code #

- 1. Public Land Survey T 4S R 3E M-10
2. Property Controlling in Section S T R
3. Miscellaneous Property in Sec. S T R

RECORDED WASHTEENAW COUNTY, MI DEC 1 11 40 AM '94 PEGGY M. HAINES COUNTY CLERK/REGISTRAR - COPY -

Register of Deeds Stamp & File Number

- 4. Lot No. , Recorded Plat
5. Private Claims

Grid table with columns A-M and rows 2-13, containing numbers 1-36.

I, Patrick L. Hastings in a field survey on October 7, 1994, do hereby certify that under requirements of P.A. 74, Michigan P.A. of 1970, the corner points mentioned in lines 1 and 2 above were in conformance with regulations and rules therefore as required in the current manual of survey instructions of the United States Department of the Interior, Bureau of Land Management or by a decree of a Court of Law and/or that the corner points mentioned in lines 3, 4 and 5 above were in conformance with the rules of the Michigan Board of Land Surveyors or by a Decree of a Court of Law; established, re-established, monumented, re-monumented, recovered, found as expressed below:

NOTE: Not more than 4 corners, all in the same town and range, may be recorded on this certificate.

A. Description of original monument and accessories and/or subsequent restoration:

- 1816 Subdivision of Township. Set post at 40 chains (1) W Oak 9" N 82° E 12 lks (2) Hickory 10" N 19° W 26 lks
1824 Township GLO Plat by John M. Mack
1932 W.C.R.C. Grid Book by W.J. Armstrong. Set this corner to fit the range line and the lines of occupation (3) S 38° W 38.2' 18" Hickory (4) N 53° W 26.9' 18" Hickory

CONTINUED ON BACK


B. Description of corner evidence found and/or method applied in restoring or reestablishing corner:

- 1994 Found 1 1/4" x 24" iron pipe 2' east of west edge of gravel road. There are no occupational fence lines west or east. (6) S 50° E 33' Very Rotted Stump (7) S 45° E 35.80' 10" Hickory Nail and Tag (8) S 40° W 33.65' 18" Hickory Scar (9) Gone

C. Description of monument for corner and accessories established to perpetuate locating the position of the corner:

After a careful study of the record documentation and field observations, made under my direct supervision, I find this corner as remonumented to be the best available evidence of the position of the original corner.

CONTINUED ON BACK

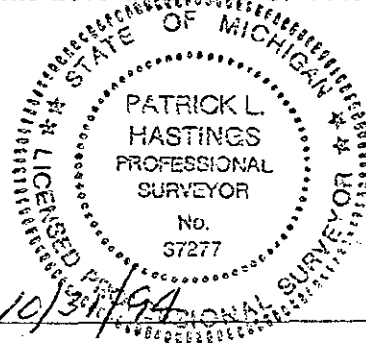

Signed by Patrick L. Hastings Date 10/31/94 Surveyor's Michigan License No. 37277

SECTION 'A' CONTINUED

1932	(5)	N 12° W	94.6'	6" Hickory
	(6)	S 51 1/2° E	32.1'	18" Elm
1942	W.C.R.C. Grid Book Plat			
	North	2671.0'	N.E. Cor. of Section	
	South	2680.6'	S.E. Cor. of Section	
1980	Survey by Werner E. Sommer			
	(6)	S 50° E	32.96'	28" Stump
	(7)	S 45° E	35.80'	6" Hickory
	(8)	S 40° W	33.65'	14" Hickory
	(9)	N 50° W	52.45'	14" Apple
1980	L.C.R.C. by Werner E. Sommer, Found 1 1/2" iron pipe. Nail & disc as follows			
	(6)	S 50° E	32.96'	28" Stump
	(7)	S 45° E	35.80'	6" Hickory
	(8)	S 40° W	33.65'	14" Hickory
	(9)	N 50° W	52.45'	14" Apple

SECTION 'C' CONTINUED

1994	Set 1" x 24" iron pipe inside found 1 1/4" iron pipe with remonumentation cap and #37277 6" below surface.			
	(6)	S 50° E	32.96'	28" Stump RT & PK
	(7)	S 45° E	35.80'	6" Hickory RT & PK
	(8)	S 40° W	33.65'	14" Hickory RT & PK
	(10)	S 85° E	20.66'	8" Hickory
	(11)	N 20° E	74.28'	12" Walnut
	(12)	West	2'±	Edge of Gravel Road

APPROVED

DATE 10/31/94CO. REP. KJ