

COPY

- copy -

MAY - 1 1995

LAND CORNER RECORDATION CERTIFICATE  
Filing Requirement of Act 74, Mich. P.A. 1970

For corners in

COMMISSION

Washtenaw  
(County)

Located In:

Corner Code ##

1. Public Land Survey	T	4S	R	3E	M-11
	T		R		
	T		R		
	T		R		
2. Property Controlling in Section	S		T	R	
	S		T	R	
3. Miscellaneous Property in Sec.	S		T	R	
	S		T	R	

RECORDED  
 WASHTENAW COUNTY, MI  
 DEC 1 11 40 AM '94  
 PEGGY N. HAINES  
 COUNTY CLERK/REGISTRAR  
 - COPY -

Register of Deeds Stamp & File Number

- 4. Lot No. \_\_\_\_\_, Recorded Plat \_\_\_\_\_
- 5. Private Claims \_\_\_\_\_

Patrick L. Hastings in a field survey on October 7, 1994, do hereby certify that under requirements of P.A. 74, Michigan P.A. of 1970, the corner points mentioned in lines 1 and 2 above were in conformance with regulations and rules therefore as required in the current manual of survey instructions of the United States Department of the Interior, Bureau of Land Management or by a decree of a Court of Law and/or that the corner points mentioned in lines 3, 4 and 5 above were in conformance with the rules of the Michigan Board of Land Surveyors or by a Decree of a Court of Law; established, re-established, monumented, re-monumented, recovered, found as expressed below:

A	B	C	D	E	F	G	H	I	J	K	L	M
2	6	5	4	3	2	1						
3												
4	7	8	9	10	11	12						
5												
6	18	17	16	15	14	13						
7												
8	19	20	21	22	23	24						
9												
10	30	29	28	27	26	25						
11												
12	31	32	33	34	35	36						
13												

NOTE: Not more than 4 corners, all in the same town and range, may be recorded on this certificate.

A. Description of original monument and accessories and/or subsequent restoration:

- 1815 Township Boundary Set Post, Dep. Surveyor Hough  
(1) W. Oak N 47° E 32 lks  
(2) Oak N 62° W 10 lks
- 1816 Subdivision of Township Fieldnotes
- 1824 Township GLO Plat by John M. Mack

CONTINUED ON BACK


B. Description of corner evidence found and/or method applied in restoring or reestablishing corner:

- 1994 Found 3/4" iron pipe tightly surrounded with brick. Removed first layer of brick and found a second layer. Iron pipe is 8" below surface of road and is situated along the east edge of gravel road. No occupation lines east or west.  
(3) N 30° E 12.0' 12" Stump (Elm)  
(4) S 57 1/2° E 12.23' 14" Hickory to Nail and Shiner  
(5) S 31 1/2° E 26.80' 14" Hickory to Nail and Shiner  
(6) S 14° E 50.3' 14" Hickory Side Center  
(7) S 87° W 36.3' 14" Hickory Side Center  
(10) N 22° W 77.5' 24" Osage Orange Side Center

C. Description of monument for corner and accessories established to perpetuate locating the position of the corner:

After a careful study of the record documentation and field observations, made under my direct supervision, I find this corner monument to be the best available evidence of the position of the original corner.

CONTINUED ON BACK

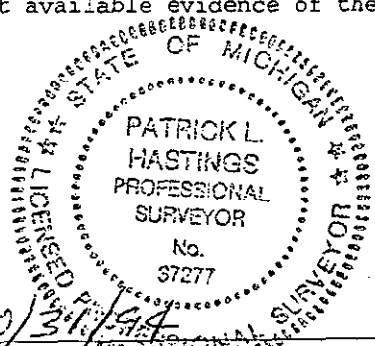

igned by Patrick L. Hastings  
 Surveyor's Michigan License No. 37277

Date 10/31/94

1

SECTION 'A' CONTINUED

1936 W.C.R.C. Grid Book, by W.J. Armstrong, old stake gone. Set this corner according to S. Wilburg survey made about 40 years ago. Set iron pipe, stones and broken brick.  
 Typed  
 (3) N 52° E 12.0' 8" Twin Elm  
 (4) S 57 1/2° E 12.5' 6" Hickory  
 (5) S 31 1/2° E 26.6' 12" Hickory  
 (6) S 14° E 50.3' 6" Hickory  
 (7) S 87° W 36.4' 6" Hickory  
 (8) East 33.0' R/W Iron  
 (9) West 33.0' R/W Iron  
 Written  
 (4) S 57° E 12.25' 11" Hickory  
 (5) S 29° E 26.35' 12" Hickory  
 (6) S 11° E 50.37' 9" Hickory  
 (10) N 22° W 76.48' 17" Osage  
 (11) West 36.26' 11" Hickory

1942 W.C.R.C. Grid Book Plat. North to E 1/4 Corner 2680.6 by W.J.A.

No Date By A.H. Inc., Drawing, Compilation of records.  
 (3) N 52° E 12.0' 8" Twin Elm  
 (4) S 57 1/2° E 12.5' 6" Hickory  
 (5) S 31 1/2° E 26.6' 12" Hickory  
 (6) S 14° E 50.3' 6" Hickory  
 (7) S 87° W 36.4' 6" Hickory

1978 Survey by R. Timothy Tietsema, corner shown by symbol. No witnesses

1987 Recovered by Glen Richards. Found 1 1/2" iron pipe and bricks from record witness. Iron rusty and top hit and bent. Replaced with 1 1/2" x 24" iron pipe, deep and raised with a 1" x 26" iron pipe. Witnessed using record.  
 (3a) N 52° E 12.00' 6" Elm, Nail and Disc.  
 (4) S 57° E 12.25' 14" Hickory, Nail and Disc.  
 (5a) S 29° E 29.85' 14" Hickory, Nail and Disc.  
 (11) West 36.26' 12" Hickory, Nail and Disc.  
 Corner on east edge of road

1987 L.C.R.C. by Werner Sommer, for above survey by Glen Richards  
 (3a) N 52° E 12.00' 6" Elm, Nail and Disc.  
 (4) S 57° E 12.25' 14" Hickory, Nail and Disc.  
 (5a) S 29° E 29.85' 14" Hickory, Nail and Disc.  
 (11) West 36.26' 12" Hickory, Nail and Disc.

1987 Survey by Werner E. Sommer  
 (3a) N 52° E 12.00' 6" Elm, Nail and Disc.  
 (4) S 57° E 12.25' 14" Hickory, Nail and Disc.  
 (5a) S 29° E 29.85' 14" Hickory, Nail and Disc.  
 (11) West 36.26' 12" Hickory, Nail and Disc.

1987 L.C.R.C. by Werner E. Sommer  
 (3a) N 52° E 12.00' 6" Elm, Nail and Disc.  
 (4) S 57° E 12.25' 14" Hickory, Nail and Disc.  
 (5a) S 29° E 29.85' 14" Hickory, Nail and Disc.  
 (11) West 36.26' 12" Hickory, Nail and Disc.

1988 L.C.R.C. by Robert Campbell, L. 7 Pg. 195, Found iron pipe at E. edge of gravel 3" below road surface.  
 (3A) 6" Elm N 40° E 12.03 to Flasher  
 (4) 14" Hickory S 57° E 12.24 to Flasher  
 (5) 16" Hickory S 29° E 26.83' to Flasher  
 (6) 13" Hickory S 11° E 50.3' to Center  
 (10) 17" Osage N 22° W 77.5' to Center

1990 Survey by Richard G. Timmons  
 (4) S 57° E 12.25' 12" Hickory  
 (5) S 29° E 26.85' 12" Hickory  
 (6) S 11° E 50.37' 9" Hickory  
 (11) West 36.26' 12" Hickory

SECTION 'C' CONTINUED

1992 Set standard remonumentation cap on existing 3/4" iron pipe stamped #37277 8" below surface.  
 (4) S 57 1/2° E 12.23' 14" Hickory RT & PK  
 (5) S 31 1/2° E 26.80' 14" Hickory RT & PK  
 (6) S 14° E 50.30' 14" Hickory RT & PK  
 (7) S 87° W 36.33' 14" Hickory RT & PK  
 (10) N 22° W 77.48' 24" Osage Orange RT & PK

APPROVED  
 DATE 10/31/94  
 CO. REP. KA