

COPY

- Copy -

MAY - 1 1995

LAND CORNER RECORDATION CERTIFICATE
Filing Requirement of Act 74, Mich. P.A. 1970

For corners in COMMISSION

Washtenaw (County)	Located In:	Corner Code #
1. Public Land Survey	T 4S R 3E	M-12
	T R	
	T R	
	T R	
2. Property Controlling in Section	S T R	
	S T R	
3. Miscellaneous Property in Sec.	S T R	
	S T R	

RECORDED
 WASHTENAW COUNTY, MI
 DEC 1 11 42 AM '94
 PEGGY M. HAINES
 COUNTY CLERK/REGISTER

Register of Deeds Stamp & File Number

4. Lot No. _____, Recorded Plat _____
 5. Private Claims _____

	A	B	C	D	E	F	G	H	I	J	K	L	M
2	6	5	4	3	2	1							
3													
4	7	8	9	10	11	12							
5													
6	18	17	16	15	14	13							
7													
8	19	20	21	22	23	24							
9													
10	30	29	28	27	26	25							
11													
12	31	32	33	34	35	36							
13													

I, Patrick L. Hastings in a field survey on October 7, 1994, do hereby certify that under requirements of P.A. 74, Michigan P.A. of 1970, the corner points mentioned in lines 1 and 2 above were in conformance with regulations and rules therefore as required in the current manual of survey instructions of the United States Department of the Interior, Bureau of Land Management or by a decree of a Court of Law and/or that the corner points mentioned in lines 3, 4 and 5 above were in conformance with the rules of the Michigan Board of Land Surveyors or by a Decree of a Court of Law; established, re-established, monumented, re-monumented, recovered, found as expressed below:

NOTE: Not more than 4 corners, all in the same town and range, may be recorded on this certificate.

A. Description of original monument and accessories and/or subsequent restoration:

- 1815 Township Boundary
 - (1) Linden - 12" S 30° E 32 lks
 - (2) B. Walnut - 12" S 82° W 43 lks
- 1824 Township GLO Plat by John M. Mack
- 1933 W.C.R.C. Grid Book, by W.J. Armstrong. Found old wood stake. Set 1 1/2" x 42" iron pipe with stones and bricks around it.
 - (3) N 18° E 62.8' 8" Elm
 - (4) N 9° E 169.8' 32" Red Oak
 - (5) 10' W & 35'E Taper Wooden Stake

CONTINUED ON BACK

B. Description of corner evidence found and/or method applied in restoring or reestablishing corner:

- 1994 Found 1 1/2" x 40" iron pipe. The pipe was leaning slightly to the south and has a pinched top. Did not find any brick to a depth of 2'. Found yellow cap #27453 RGM in hole. Iron is situated 3' east of the west edge of a N-S gravel road. There is no line of occupation east or west.
 - (4) N 9° E 170.0' 52" Red Oak Stump
 - (6) N 75° E 20.07' Quad 8" Walnut; Westerly tree, Found PK
 - (7) S 40° E 39.36' 12" Elm Fd. PK
 - (8) N 53° W 41.88' Iron Pipe


C. Description of monument for corner and accessories established to perpetuate locating the position of the corner:

After a careful study of the record documentation and field observations, made under my direct supervision, I find this corner to be a careful and faithful perpetuation of the position of the original corner.

CONTINUED ON BACK

igned by Patrick L. Hastings
 Surveyor's Michigan License No. 37277

Date 10/31/94

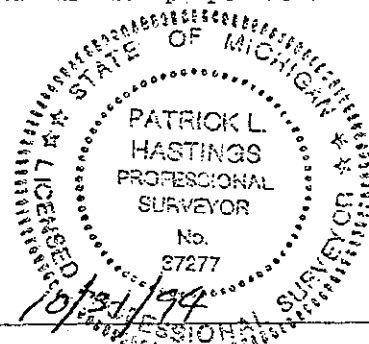

- copy -

SECTION 'A' CONTINUED

1936 W.C.R.C. Grid Book plat south to SE corner of Section 2688.0'

No Date By A.H., Inc. Drawing, Compilation of records
 (3) N 18° E 62.8' 8" Elm
 (4) N 9° E 169.8' 32" Red Oak

1978 Survey by R. Timothy Tietsema, corner shown by symbol.
 No witnesses

1990 Survey by Richard G. Timmons, found iron pipe
 (5) S 80° W 13.63' 6" Elm
 (6) N 75° E 20.04' 6" Ash
 (7) S 40° E 39.32' 12" Oak
 (8) N 53° W 41.92' Iron pipe with cap

SECTION 'C' CONTINUED

1994 Cut off pinch top of 1 1/4" now 36" long and set a 1" x 12" iron pipe
 inside of 1 1/4" with remonumentation cap stamped 37277, 7" below surface
 (6) N 75° E 20.07' 8" Walnuts; westerly tree, RT & PK
 (7) S 40° E 39.36' 12" Elm, RT & PK
 (8) N 53° W 41.88' Iron pipe #27453 A.H.L.L.S.
 (9) N 80° W 34.02' 8" W. Oak RT & PK
 (10) S 25° W 38.67' 8" Ash RT & PK

APPROVED

DATE 10/31/94

CO. REP. KA

7