

SURVEY & REMONUMENTATION

COPY

RECORDED
WASHTENAW COUNTY, MI

FEB 1 8 46 AM '95

MAY - 1 1995

LAND CORNER RECORDATION CERTIFICATE
Filing Requirement of Act 74, Mich. P.A. 1970

PEGGY M. HAINES
COUNTY CLERK/REGISTER

For corners in **COMMISSION**

WASHTENAW (County)	Located In:	Corner Code #
1. Public Land Survey	T <u>4 S</u> R <u>4 E</u>	<u>1-10</u>
	T _____ R _____	_____
	T _____ R _____	_____
	T _____ R _____	_____
2. Property controlling in Section	S _____ T _____ R _____	_____
	S _____ T _____ R _____	_____
3. Miscellaneous Property in Sec.	S _____ T _____ R _____	_____
	S _____ T _____ R _____	_____
4. Lot No. _____, Recorded Plat _____		
5. Private Claims _____		

-COPY-

LIBER 1 PAGE 339 RM
COPY
Register of Deeds Stamp & File Number

	A	B	C	D	E	F	G	H	I	J	K	L	A
2	6	5	4	3	2	1							
3													
4	7	8	9	10	11	12							
5													
6	16	17	18	19	20	21	22	23	24				
7													
8	18	20	21	22	23	24							
9													
10	30	28	28	27	26	25							
11													
12	31	32	33	34	35	36							
13													

I, Paul V. Schwimmer, in a field survey on October 21, 19 93, do hereby certify that under requirements of P.A. 74, Michigan P.A. of 1970, the corner points mentioned in lines 1 and 2 above were in conformance with regulations and rules therefore as required in the current manual of survey instructions of the United States Department of the Interior, Bureau of Land Management or by decree of a Court of Law and/or that the corner points mentioned in lines 3, 4 and 5 above were in conformance with the rules of the Michigan Board of Land Surveyors or by Decree of a Court of Law; established, re-established, monumented, re-monumented, recovered, found as expressed below:

NOTE: Not more than 4 corners, all in the same town and range, may be recorded on this certificate

A. Description of original monument and accessories and/or subsequent restoration:

Post, CLO August 31, 1819
1) R. Oak N 88° E 55 links
2) W. Oak N 81° W 25 links

No other information available

B. Description of corner evidence and/or method applied in restoring or reestablishing corner:

Found 3/4" iron pipe 3" below road surface. Offset and removed iron pipe. Found no other evidence of a corner monument. Iron pipe is 1.5' East of a North/South fence line to the South.

Found following accessories:


- 3) Oak 36" N 30° W 24.45' to nail & disc in S. side.
- 4) Twin 12" Oak N 65° W 35.13' to nail & disc in S. side.
- 5) Triple Oak (15", 22", & 7") N 60° E 47.89' to nail & disc in S. side 15" oak, most westerly.
- 6) Oak 12" N 70° W 55.92' to 2 headed nail in S. side.
- 7) Quad Elm stumps (12", 12", 14", & 14") S 40° E 32.34' to nail driven vertically into center of center most stump.
- 8) Elm 6" S 65° W 43.03' to nail in N. side.

C. Description of monument for corner and accessories established to perpetuate locating the position of the corner:

Reset 1" x 24" iron pipe with 2" aluminum Remonumentation cap 6" below road surface.

Set additional accessories

- 9) Hickory 5" S 55° W 39.71' to PK nail in NE side.
- 10) Hickory 3" S 50° E 34.58' to PK nail in N. side.

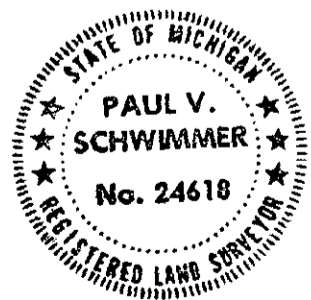

I believe this point should be accepted as the best available evidence of the original corner.

Signed by Paul V. Schwimmer Date 12/29/94
Surveyor's Michigan License No. 24618

APPROVED
DATE 12/12/94
CO DEP 1/2