

**SURVEY & REMONUMENTATION**

**COPY**

RECORDED  
WASHTENAW COUNTY, MI

MAY - 1 1995

**LAND CORNER RECORDATION CERTIFICATE**  
Filing Requirement of Act 74, Mich. P.A. 1970

FEB 1 8 49 AM '95

For corners in **COMMISSION**

PEGGY H. HAINES  
COUNTY CLERK/REGISTER

WASHTENAW (County)	Located In:	Corner Code #
1. Public Land Survey	T <u>4</u> S R <u>4</u> E	<u>I-11</u>
	T _____ R _____	_____
	T _____ R _____	_____
	T _____ R _____	_____
2. Property controlling in Section	S _____ T _____ R _____	_____
	S _____ T _____ R _____	_____
3. Miscellaneous Property in Sec.	S _____ T _____ R _____	_____
	S _____ T _____ R _____	_____

*-COPY-*

LIBER 1 PAGE 340 RM  
COPY

Register of Deeds Stamp & File Number

4. Lot No. \_\_\_\_\_, Recorded Plat \_\_\_\_\_  
5. Private Claims \_\_\_\_\_

I, Paul V. Schwimmer, in a field survey on October 21, 19 93, do hereby certify that under requirements of P.A. 74, Michigan P.A. of 1970, the corner points mentioned in lines 1 and 2 above were in conformance with regulations and rules therefore as required in the current manual of survey instructions of the United States Department of the Interior, Bureau of Land Management or by decree of a Court of Law and/or that the corner points mentioned in lines 3, 4 and 5 above were in conformance with the rules of the Michigan Board of Land Surveyors or by Decree of a Court of Law; established, re-established, monumented, re-monumented, recovered, found as expressed below:

	A	B	C	D	E	F	G	H	I	J	K	L	A
2	6	5	4	3	2	1							
3													
4	7	8	9	10	11	12							
5													
6	18	17	16	15	14	13							
7													
8	19	20	21	22	23	24							
9													
10	30	29	28	27	26	25							
11													
12	31	32	33	34	35	36							
13													

NOTE: Not more than 4 corners, all in the same town and range, may be recorded on this certificate

**A. Description of original monument and accessories and/or subsequent restoration:**

Set post in prairie GLO August 31, 1819  
No bearing trees.

- No description of corner monument  
1) Maple 40° N 35° W 74.48' to spike in root.  
2) Maple 10° N 45° E 68.98' to spike.  
3) Electric pole S 45° E 3.97'

Glenn E. Richards LS# 13040  
Survey L1447 P800  
5/3/1973

- Found cluster of stones in swamp.  
Traces of N/S & E/W fences.  
Set 3/4" x 4' iron pipe  
1) Maple 40° N 35° W 74.48' to spike in root.  
2) Maple 10° N 45° E 68.98' to spike.  
3) Electric pole S 45° E 3.97'

Glenn E. Richard LS# 13040  
LCRC L3 P145  
5/24/73

**B. Description of corner evidence and/or method applied in restoring or reestablishing corner:**

Found 3/4" x 48" capped iron pipe. Cap unreadable  
Also found remaining witnesses set by Glenn Richards:  
1) Maple 40° N 35° W did not find spike in root, set pk in SE root measures 74.42'  
3) Power pole S 45° E 4.11' to nail in N. side.


**C. Description of monument for corner and accessories established to perpetuate locating the position of the corner:**

Set 2" aluminum Remonumentation cap on existing 3/4" x 48" iron pipe.

- Set additional accessories:  
4) Maple 18° S 03° W 48.63' to PK nail in W side.  
5) Maple 14° N 20° E 79.89' to PK nail in E side.

Corner falls in area cleared for power line. Medium to heavy woods on each side of power line.

believe this point should be accepted as the best available evidence of the original corner.

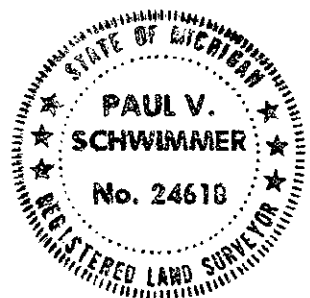

Signed by Paul V. Schwimmer  
Surveyor's Michigan License No. 24618

Date 12/29/94

APPROVED  
DATE 12/12/94  
CO. DEP. 1/1