SURVEY & REMONUMENTATION

MAY - 1 1995

COMMISSION

COPY

RECORDED
WASHTENAW COUNTY, MI

FEB 1 8 50 AM '95

PEGGY M. HAINES
COUNTY CLERK/REGISTER

- COPY -

LAND CORNER RECORDATION CERTIFICATE

Filing Requirement of Act 74, Mich. P.A. 1970

For corners in WASHTENAW (County)

	Located In:		Corner Code #
1. Public Land Survey	T 4 S	R 4 E	J-9
	T	R	
	T	R	
	T	R	
2. Property controlling	S T	R	
in Section	S T	R	
3. Miscellaneous	S T	R	
Property in Sec.	S T	R	

LIBER 1 PAGE 343 RM

COPY

Register of Deeds Stamp & File Number

4. Lot No. _____, Recorded Plat _____

5. Private Claims _____

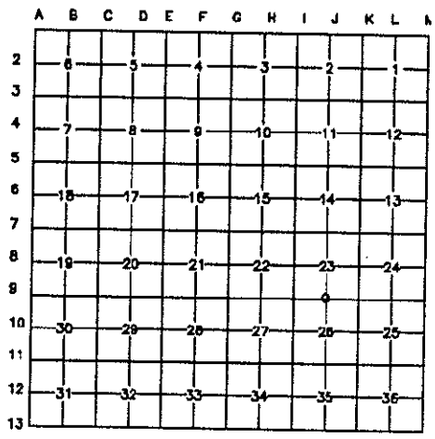

I, Paul V. Schwimmer, in a field survey on October 22, 19 93, do hereby certify that under requirements of P.A. 74, Michigan P.A. of 1970, the corner points mentioned in lines 1 and 2 above were in conformance with regulations and rules therefore as required in the current manual of survey instructions of the United States Department of the Interior, Bureau of Land Management or by decree of a Court of Law and/or that the corner points mentioned in lines 3,4 and 5 above were in conformance with the rules of the Michigan Board of Land Surveyors or by Decree of a Court of Law; established, re-established, monumented, re-monumented, recovered, found as expressed below:

NOTE: Not more than 4 corners, all in the same town and range, may be recorded on this certificate

A. Description of original monument and accessories and/or subsequent restoration:

Post, GLO August 31,1819
1) W. Oak 20" S 12° E 28 links
2) Do 16" N 19° E 100 links

Found 1/2" iron pipe
3) Corner fence post North 25.2'
4) Corner fence post South 28.5'
5) Oak 18" N 10° E 34.0'
6) Maple 4" S 10° E 26.5'
7) Maple 14" S 50° E 93.3'

Norman N. Fahrner LS#17620
Survey job #12549, file #R-3431
11/8/74

B. Description of corner evidence and/or method applied in restoring or reestablishing corner:

Found 1/2" iron pipe 0.4' below surface of Willow Road. Corner is 1.5' west of a N-S fence line north of the road and 4.1' west of a N-S fence line south of the road.

Offset iron pipe and removed it to search for other evidence of the corner. Found no additional evidence of corner. Also found existing witnesses:

3) Corner fence post North 25.20'
4) Corner fence post S 01 E 28.52'
5) Hickory 24" N 10° E 34.0'
6) Twin maple 7" S 10° E 26.48'
7) Maple 18" S 50° E 93.21'

C. Description of monument for corner and accessories established to perpetuate locating the position of the corner:

Replaced 1/2" iron pipe with 1" x 24" iron pipe with remonumentation cap 6" below surface of Willow Road.
Set PK nail in each witnesses described in section B before measuring.
Set additional acessory to corner:
8) Oak 5" North 44.13' to PK nail in W side.

STATE OF MICHIGAN
PAUL V. SCHWIMMER
No. 24618
REGISTERED LAND SURVEYOR

believe this point should be accepted as the best available evidence of the original corner.

Signed by Paul V. Schwimmer Date 12/29/94

Surveyor's Michigan License No. 24618

APPROVED
DATE 12/12/94
CO. REP. H

FORM APPROVED BY MICHIGAN STATE BOARD OF LAND SURVEYORS, JAN. 28, 1971
REVISED MAY 14, 1975
REVISED JAN., 1983