

SURVEY &
REMONUMENTATION

MAY - 1 1995

COPY

RECORDED
WASHTENAW COUNTY, MI

FEB 1 8 50 AM '95

COMMISSION LAND CORNER RECORDATION CERTIFICATE
Filing Requirement of Act 74, Mich. P.A. 1970

PEGGY M. HAINES
COUNTY CLERK/REGISTER

- COPY -

For corners in WASHTENAW (County)	Located In:	Corner Code #
1. Public Land Survey	T 4 S R 4 E	K-10
	T _____ R _____	_____
	T _____ R _____	_____
	T _____ R _____	_____
2. Property controlling in Section	S _____ T _____ R _____	_____
	S _____ T _____ R _____	_____
3. Miscellaneous Property in Sec.	S _____ T _____ R _____	_____
	S _____ T _____ R _____	_____
4. Lot No. _____, Recorded Plat _____		
5. Private Claims _____		

LIBER 1 PAGE 347 RM
COPY
Register of Deeds Stamp & File Number

	A	B	C	D	E	F	G	H	I	J	K	L	A
2	6	9	4	3	2	1							
3													
4	7	8	8	10	11	12							
5													
6	16	17	18	15	14	13							
7													
8	19	20	21	22	23	24							
9													
10	30	29	28	27	26	25							
11													
12	31	32	33	34	35	36							
13													

I, Paul V. Schwimmer, in a field survey on October 25, 1993, do hereby certify that under requirements of P.A. 74, Michigan P.A. of 1970, the corner points mentioned in lines 1 and 2 above were in conformance with regulations and rules therefore as required in the current manual of survey instructions of the United States Department of the Interior, Bureau of Land Management or by decree of a Court of Law and/or that the corner points mentioned in lines 3, 4 and 5 above were in conformance with the rules of the Michigan Board of Land Surveyors or by Decree of a Court of Law; established, re-established, monumented, re-monumented, recovered, found as expressed below:

NOTE: Not more than 4 corners, all in the same town and range, may be recorded on this certificate

A. Description of original monument and accessories and/or subsequent restoration:

Wood post GLO August 27, 1819
(1) Hickory 12" S 48" E 8 links
(2) W. Oak 10" N 44" W 13 links

No description of corner
(3) W. Oak 10" N 14 1/2" E 25 links

Surveyor named Pettibone
Grid book
no date

No witnesses remaining
Set 1" x 24" iron pipe
on line and midway between
NW corner and SW corner of
section. Set corner 1.5' below ground - no fences
(4) Oak 24" N 06" E 151.80 to nail
(5) Oak 30" S 52" E 215.60 to nail
(6) Oak 22" S 03" W 272.55 to nail
Norman N. Fahrner LS 17620
LCRC L1 P521
11/24/71


Shown on survey by N. Fahrner LS #17620
Survey job #7561, File #R-2612
November 1971

B. Description of corner evidence and/or method applied in restoring or reestablishing corner:

Found 1" iron pipe in stones 24" below ground surface.
(4) Oak 30" N 06" E 152.08' to two headed nail & disc on E. side
(5) Oak 40" S 52" E 215.64' to two headed nail & disc on E. side
(6) Oak 30" S 03" W 272.22' to nail & disc on E. side

C. Description of monument for corner and accessories established to perpetuate locating the position of the corner:

Set additional accessory
Twin 6" Oak N 20" W 135.85' to PK nail on W. side.

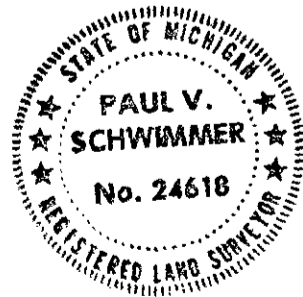

I believe this point should be accepted as the best available evidence of the original corner.

Signed by Paul V. Schwimmer Date 12/29/94
Surveyor's Michigan License No. 24618

APPROVED
DATE 12-10-94
CO. REP. B