

MAY - 1 1995

LAND CORNER RECORDATION CERTIFICATE

FEB 1 8 52 AM '95

COMMISSION

Filing Requirement of Act 74, Mich. P.A. 1970

For corners in

WASHTENAW
(County)

Located In:

Corner Code #

- | | | | |
|------------------------------------|-------|-------|------|
| 1. Public Land Survey | T 4 S | R 4 E | L-11 |
| | T | R | |
| | T | R | |
| | T | R | |
| | T | R | |
| 2. Property controlling in Section | S | T | R |
| | S | T | R |
| 3. Miscellaneous Property in Sec: | S | T | R |
| | S | T | R |
4. Lot No. _____, Recorded Plat _____
5. Private Claims _____

PEGGY M. HAINES
COUNTY CLERK/REGISTER

-COPY-

LIBER

1 PAGE 353 RM

COPY

Register of Deeds Stamp & File Number

I, Paul V. Schwimmer, in a field survey on October 19, 19 93, do hereby certify that under requirements of P.A. 74, Michigan P.A. of 1970, the corner points mentioned in lines 1 and 2 above were in conformance with regulations and rules therefore as required in the current manual of survey instructions of the United States Department of the Interior, Bureau of Land Management or by decree of a Court of Law and/or that the corner points mentioned in lines 3, 4 and 5 above were in conformance with the rules of the Michigan Board of Land Surveyors or by Decree of a Court of Law; established, re-established, monumented, re-monumented, recovered, found as expressed below:

NOTE: Not more than 4 corners, all in the same town and range, may be recorded on this certificate

A	B	C	D	E	F	G	H	I	J	K	L
2	6	5	4	3	2	1					
3											
4	7	8	9	10	11	12					
5											
6	16	17	18	19	14	13					
7											
8	19	20	21	22	23	24					
9											
10	30	29	28	27	26	25					
11											
12	31	32	33	34	35	36					
13											

A. Description of original monument and accessories and/or subsequent restoration:

Wood post GLO August 27, 1819
 1) W. Oak 24° S 50° W 31 links
 2) Hickory 13° N 71° E 30 links

No description of corner
 (3) Hickory 10° N 55 1/2° E 34.5'
 (4) Elm 16° S 66 1/2° E 71.0'
 (5) Elm 8° S 64° E 62.1'
 (6) Elm 8° S 72° W 76.5'
 (7) Elm 14° N 57 1/2° W 59.6'

Armstrong drawing 1940's

No corner found - PI for road set in center of road and range of fences N&S
 (3) Hickory 10° N 55 1/2° E 34.5'
 (4) Elm 10° S 66 1/2° E 71.0'
 (8) Elm 24° N 59° W 42.4'
 (9) Elm 6° N 28° W 24.6'

W. J. Armstrong
 Grid book
 12/29/41

1 1/2" iron pipe 8" below surface
 (5) Elm 12° S 64° E 62.1'
 (9) Elm 12° N 27° W 24.6
 (10) T. Pole S 03° E 31.8'
 (11) Hickory 12° N 05° W 34.7
 (12) Elm 36° N 57° W 48.0'

Grid book no date on witnesses.

CONTINUED ON BACK

B. Description of corner evidence and/or method applied in restoring or reestablishing corner:

Found 1 1/2" iron pipe 8" below road surface. Matched ties to the following:

- (3) Hickory 15° N 55 1/2° E 34.44' to nail on N. side
- (13) Power pole N 27° E 34.52' to nail & disc on E. side

C. Description of monument for corner and accessories established to perpetuate locating the position of the corner:

Set 3/4" X 12" iron pipe w/ remonumentation cap inside 1 1/2" iron pipe
 Set additional accessories

- (16) Juniper 10° S 60° E 47.75 to PK nail on S. side
- (17) Cedar 12° S 10° E 43.23 to PK nail on E. side
- (18) Elm 6° S 45° W 38.68' to PK nail

Noted the following additional accessory:


- (15) 3/4" iron pipe w/ cap "R.L.S. G.R. 13040" North 33.02'

I believe this point should be accepted as the best available evidence of the original corner.

Signed by Paul V. Schwimmer

Date 12/29/94

Surveyor's Michigan License No. 24618

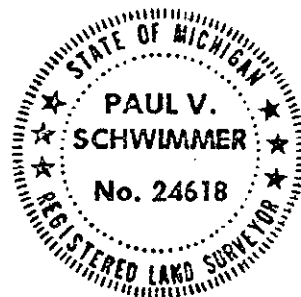

Description of original monument and accessories and/or subsequent restoration (continued from front page)

Found 1 1/2" iron pipe
(3) Hickory 12" N 55 1/2° E 34.5'
(10) T. Pole S 03° E 31.8'
(13) Power Pole N 27° E 34.8'

No description of corner
(3) Hickory 12" N 55° E 34.49' to nail
(10) T. Pole South 31.6'
(13) P. Pole N 20° E 34.57'
(14) Elm 6" S 30° E 20.05'

Norman N. Fahrner LS 17620
LCRC L1 P511
11/24/71

Werner Sommer LS 12030
Survey Job #'s 751016 & 760702
11/5/75 & 7/12/76 (Same Witnesses)

120

APPROVED

DATE 12/12/94

CO. REP. A