

SURVEY &  
REMONUMENTATION

MAY - 1 1995

COPY

RECORDED  
WASHTENAW COUNTY, MI

FEB 1 8 53 AM '95

COMMISSION LAND CORNER RECORDATION CERTIFICATE  
Filing Requirement of Act 74, Mich. P.A. 1970

For corners in

WASHTENAW (County)	Located In:	Corner Code #
1. Public Land Survey	T 4 S R 4 E	M-10
	T _____ R _____	_____
	T _____ R _____	_____
	T _____ R _____	_____
2. Property controlling in Section	S _____ T _____ R _____	_____
	S _____ T _____ R _____	_____
3. Miscellaneous Property in Sec.	S _____ T _____ R _____	_____
	S _____ T _____ R _____	_____
4. Lot No. _____, Recorded Plat _____		
5. Private Claims _____		

PEGGY M. HAINES  
COUNTY CLERK/REGISTRAR

- COPY -

LIBER 1 PAGE 357 RM  
COPY  
Register of Deeds Stamp & File Number

I, Paul V. Schwimmer, in a field survey on October 13, 19 93, do hereby certify that under requirements of P.A. 74, Michigan P.A. of 1970, the corner points mentioned in lines 1 and 2 above were in conformance with regulations and rules therefore as required in the current manual of survey instructions of the United States Department of the Interior, Bureau of Land Management or by decree of a Court of Law and/or that the corner points mentioned in lines 3, 4 and 5 above were in conformance with the rules of the Michigan Board of Land Surveyors or by Decree of a Court of Law; established, re-established, monumented, re-monumented, recovered, found as expressed below:

NOTE: Not more than 4 corners, all in the same town and range, may be recorded on this certificate

	A	B	C	D	E	F	G	H	I	J	K	L	A
2	6	5	4	3	2	1							
3													
4	7	6	5	4	3	2	1						
5													
6	16	17	18	15	14	13							
7													
8	19	20	21	22	23	24							
9													
10	30	29	28	27	26	25							
11													
12	31	32	33	34	35	36							
13													

A. Description of original monument and accessories and/or subsequent restoration:

Wood Post GLO, Feb 24, 1816

- (1) W. Oak 40" dia. bears S 66° E 48 links
- (2) W. Oak 12" dia. bears N 11° W 42 links

Found pointed stone standing on end near occupational 1/4 corner - accepted this point as 1/4 corner. Replaced stone with 1" X 24" iron pipe.

- (3) 30" Oak West 85.64' to nail
- (4) 10" Oak S 09° E 15.68' to nail
- (5) 8" Hickory N 03° E 27.25' to nail

Norman N. Fahrner LS 17620  
LCRC L1 P509  
11/24/71

Found 1" iron pipe

- (3) 30" Oak West 85.64 to nail
- (4) 10" Oak S 09° E 15.68' to nail
- (5) 8" Hickory N 03° E 27.25' to nail
- (6) 6" Oak N 30° W 11.75 to nail

I. John Jakobson LS 19836  
Survey  
09/06/83

B. Description of corner evidence and/or method applied in restoring or reestablishing corner:


Found 1" iron pipe in remains of old fence line. Matched witnesses described on 1983 Jakobson survey

C. Description of monument for corner and accessories established to perpetuate locating the position of the corner:

Set remonumentation cap on existing 1" iron pipe. Rewitnessed corner to found accessories.

- (3) Set PK on N. side 36" Oak Wly. 85.04'
- (4) Set PK on E. side 18" Oak S 09° E 15.67'
- (5) Set PK on W. side 10" Hickory N 03° E 27.65'
- (6) Set PK on W. side 8" Oak N 30° W 11.91'

I believe this point should be accepted as the best available evidence of the position of the original corner.

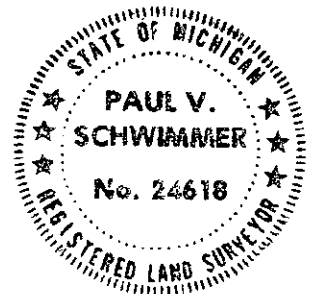

Signed by Paul V. Schwimmer  
Surveyor's Michigan License No. 24618

Date 12/29/94

APPROVED  
DATE 12/12/94  
CO. REP. KA