

**SURVEY &  
REMONUMENTATION**

MAY - 1 1995

**COMMISSION**

**COPY**

LAND CORNER RECORDATION CERTIFICATE  
Filing Requirement of Act 74, Mich. P.A. 1970

RECORDED  
WASHTENAW COUNTY, MI

FEB 1 8 53 AM '95

For corners in

| WASHTENAW<br>( County )               | Located In:             | Corner Code # |
|---------------------------------------|-------------------------|---------------|
| 1. Public Land Survey                 | T 4 S R 4 E             | M-12          |
|                                       | T _____ R _____         | _____         |
|                                       | T _____ R _____         | _____         |
|                                       | T _____ R _____         | _____         |
| 2. Property controlling<br>in Section | S _____ T _____ R _____ | _____         |
|                                       | S _____ T _____ R _____ | _____         |
| 3. Miscellaneous<br>Property in Sec.  | S _____ T _____ R _____ | _____         |
|                                       | S _____ T _____ R _____ | _____         |
| 4. Lot No. _____, Recorded Plat _____ |                         |               |
| 5. Private Claims _____               |                         |               |

PEGGY M. HAINES  
COUNTY CLERK/REGISTER

- COPY -

LIBER 1 PAGE 359 RM  
Register of Deeds Stamp & File Number

I, Paul V. Schwimmer, in a field survey on \_\_\_\_\_, 19\_\_\_\_, do hereby certify that under requirements of P.A. 74, Michigan P.A. of 1970, the corner points mentioned in lines 1 and 2 above were in conformance with regulations and rules therefore as required in the current manual of survey instructions of the United States Department of the Interior, Bureau of Land Management or by decree of a Court of Law and/or that the corner points mentioned in lines 3,4 and 5 above were in conformance with the rules of the Michigan Board of Land Surveyors or by Decree of a Court of Law; established, re-established, monumented, re-monumented, recovered, found as expressed below:

NOTE: Not more than 4 corners, all in the same town and range, may be recorded on this certificate

|    |    |    |    |    |    |    |   |   |   |   |   |   |   |
|----|----|----|----|----|----|----|---|---|---|---|---|---|---|
|    | A  | B  | C  | D  | E  | F  | G | H | I | J | K | L | A |
| 2  | 6  | 5  | 4  | 3  | 2  | 1  |   |   |   |   |   |   |   |
| 3  |    |    |    |    |    |    |   |   |   |   |   |   |   |
| 4  | 7  | 8  | 9  | 10 | 11 | 12 |   |   |   |   |   |   |   |
| 5  |    |    |    |    |    |    |   |   |   |   |   |   |   |
| 6  | 18 | 17 | 16 | 15 | 14 | 13 |   |   |   |   |   |   |   |
| 7  |    |    |    |    |    |    |   |   |   |   |   |   |   |
| 8  | 12 | 20 | 21 | 22 | 23 | 24 |   |   |   |   |   |   |   |
| 9  |    |    |    |    |    |    |   |   |   |   |   |   |   |
| 10 | 30 | 29 | 28 | 27 | 26 | 25 |   |   |   |   |   |   |   |
| 11 |    |    |    |    |    |    |   |   |   |   |   |   |   |
| 12 | 31 | 32 | 33 | 34 | 35 | 36 |   |   |   |   |   |   |   |
| 13 |    |    |    |    |    |    |   |   |   |   |   |   |   |

A. Description of original monument and accessories and/or subsequent restoration:


Set post in prairie, no bearings  
GLO, February 24, 1816

B. Description of corner evidence and/or method applied in restoring or reestablishing corner:

Found no evidence of corner. The location for the corner falls in a cultivated field and was determined to be lost. Having found no other surveys from which to reestablish the corner the corner was set a a point half way between the SE corner and the NE corner of the section.

C. Description of monument for corner and accessories established to perpetuate locating the position of the corner:

- Set 1 1/2" x 24" iron pipe with 2" aluminum remonumentation cap 1.0' below surface of cultivated field  
Set accessories in nearest trees:
- 1) Walnut 22" N 50° E 212.42' to nail & disc set in S side.
  - 2) Walnut 12" N 60° E 209.09' to nail & disc set in S side.
  - 3) Walnut 12" N 80° E 347.91' to nail & disc set in S side.
  - 4) Cottonwood 10" N 50° W 282.11' to nail & disc set in E side.

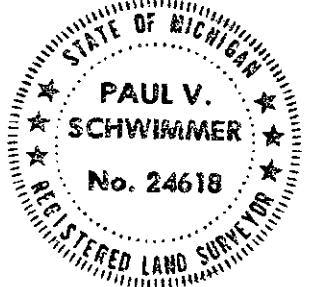

I believe this point should be accepted as the best available evidence of the position of the original corner.

Signed by Paul V. Schwimmer  
Surveyor's Michigan License No. 24618

Date 12/29/94

APPROVED  
DATE 12/12/94  
CO. REP. MA