

MAY - 1 1995

COPY

COMMISSION

LAND CORNER RECORDATION CERTIFICATE

Filing Requirement of Act 74, Mich. P.A. 1970

For corners in

Washtenaw

Located in: SALINE Corner Code

County

- 1. Public Land Survey T 4 S R 5 E K-10
- T _____ R _____
- T _____ R _____
- T _____ R _____
- 2. Property Controlling S _____ T _____ R _____
- in Section S _____ T _____ R _____
- 3. Miscellaneous S _____ T _____ R _____
- Property in Sec. S _____ T _____ R _____
- 4. Lot No. _____, Recorded Plat _____
- 5. Private Claims _____

LIDER

1 PAGE 363 RM
COPY

Register of Deeds Stamp and File Number

I, Michael S. Hoben in a field survey on 10/17/1994 do hereby certify that under requirements of P.A. 74, Michigan P.A. of 1970, the corner points mentioned in lines 1 and 2 above were in conformance with regulations and rules therefore as required in the current manual of survey instructions of the United States Department of the Interior, Bureau of Land Management, or by a decree of a Court of Law and/or that the corner points mentioned in lines 3, 4 and 5 above were in conformance with the rules of the Michigan Board of Land Surveyors or by a Decree of a Court of Law, established, re-established, monumented, re-monumented, recovered, found as expressed below.

NOTE: Not more than 4 corners, all in the same town and range, may be recorded on this certificate.

	A	B	C	D	E	F	G	H	I	J	K	L	I
2	6	5	4	3	2	1							
3													
4	7	8	9	10	11	12							
5													
6	18	17	16	15	14	13							
7													
8	19	20	21	22	23	24							
9													
10	30	29	28	27	26	25							
11													
12	31	32	33	34	35	36							
13													

A. Description of original monument and accessories and/or subsequent restorations:

07/21/1819 G.L.O. G.L.O. SET POST
 12" LILIAK TREE S 25 E 11 LINKS
 10" SUGAR TREE N 24 W 29 LINKS


B. Description of corner evidence found and/or method applied in restoring or reestablishing corner:

FD. 1/2" X 48" IRON
 PIPE AT
 INTERSECTION OF
 FENCE LINES TO THE
 NORTH & WEST

C. Description of monument for corner and accessories established to perpetuate locating the position of the corner:

10/17/1994 HOBEN 35994 O.H.M. REMON
 LEFT 1 1/2" I.P. WITH W.C.R. CAP
 FD. COR. BY USING SINGLE PROPORTION ALONG THE WEST LIN
 1 P.K. NAIL W/W.C.R. TAG ON W. SIDE 12' ELM N 45 E 3.46'
 2 P.K. NAIL W/W.C.R. TAG ON N. SIDE 12" ELM WEST 15.68'
 3 P.K. NAIL W/W.C.R. TAG ON E. SIDE 16" OAK WEST 34.52'
 4 P.K. NAIL W/W.C.R. TAG IN 5" ELM N SIDE 19.81'
 5 DIST. TO THE NW COR. = 2650.98'
 6 DIST TO THE SW COR. = 2678.58'
 7 INTERIOR ANGLE = 179-21'33'

RECORDED
 WASHTENAW COUNTY, MI
 FEB 1 8 53 AM '95
 PEGGY H. MANES
 COUNTY CLERK/REGISTER
 - COPY -

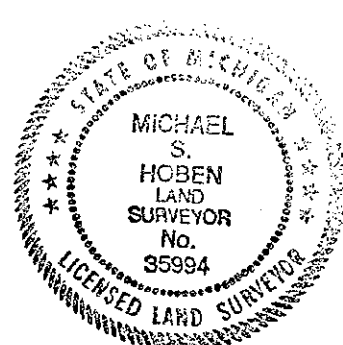

We conclude that after careful study of the record documentation and field observations, that this corner is accepted as the best available evidence of the position of the original corner.

Signed by Michael S. Hoben
 Drafted by Michael S. Hoben
 Surveyor's Michigan License No. 35994

Date Dec 29 1994

APPROVED
 DATE 12/19/94
 CO. REP. K