

SURVEY &
REMONUMENTATION

COPY

MAY - 1 1995

LAND CORNER RECORDATION CERTIFICATE

Filing Requirement of Act 74, Mich. P.A. 1970

COMMISSION

K-12 Page 1

For corners in

Washtenaw

Located in: SALINE Corner Code

County

Public Land Survey

T 4 S R 5 E K-12

Property Controlling
in Section

S _____ T _____ R _____

Miscellaneous

S _____ T _____ R _____

Property in Sec.

S _____ T _____ R _____

Lot No. _____, Recorded Plat _____
Private Claims _____

LIBER

1 PAGE 366 RM
COPY

Register of Deeds Stamp and File Number

Michael S. Hoben in a field survey on 08/31/1994
do hereby certify that under requirements of P.A. 74, Michigan P.A. of 1970, the corner points mentioned in lines 1 and 2 above were in conformance with regulations and rules therefore as required in the current manual of survey instructions of the United States Department of the Interior, Bureau of Land Management, or by a decree of a Court of Law and/or that the corner points mentioned in lines 3, 4 and 5 above were in conformance with the rules of the Michigan Board of Land Surveyors or by a Decree of a Court of Law, established, re-established, monumented, re-monumented, recovered, found as expressed below.

NOTE: Not more than 4 corners, all in the same town and range, may be recorded on this certificate.

	A	B	C	D	E	F	G	H	I	J	K	L	M
2	6	5	4	3	2	1							
3													
4	7	8	9	10	11	12							
5													
6	18	17	16	15	14	13							
7													
8	19	20	21	22	23	24							
9													
10	30	29	28	27	26	25							
11													
12	31	32	33	34	35	36							
13													

Description of original monument and accessories and/or subsequent restorations:

07/21/1819

SET POST

8" BEACH S 35 E 24 LINKS
16" BEACH NORTH 4 LINKS

(Witnesses Continued on Back ...)

Description of corner evidence found and/or method applied in restoring or reestablishing corner:

F.D. 1/2" I.R, THAT FITS
OCCUPATION.

Description of monument for corner and accessories established to perpetuate locating the position of the corner:

08/31/1994 HOBEN 35994 O.H.M. INC. REMON

SET REMON. CAP OVER RICHARD'S CORNER.


- 4 P.K. NAIL W / W.C.R. TAG IN E. SIDE OF QUAD ELMS N 20 W 77.09
- 5 P.K. NAIL WITH W.C.R. TAG ON S. SIDE OF 13" STUMP N 41 E 43.1
- 6 P.K. NAIL W/W.C.R. TAG ON W SIDE P.P. S 15 E 141.30'
- 13 P.K. NAIL W / W.C.R. TAG ON N SIDE 28" ELM N 86 E 96.20'

RECORDED
WASHTENAW COUNTY, MI
FEB 1 8 54 AM '95
PEGGY M. HAINES
COUNTY CLERK/REGISTER
-COPY-

I conclude that after careful study of the record documentation and field observations, that this corner is accepted as the best available evidence of the position of the original corner.

Signed by Michael S. Hoben
dated by Michael S. Hoben
Surveyor's Michigan License No. 35994
Richard, Hiltz and McCliment, Inc. 34935 Schoolcraft Road Livonia, MI 48150

Date Dec 28 1994

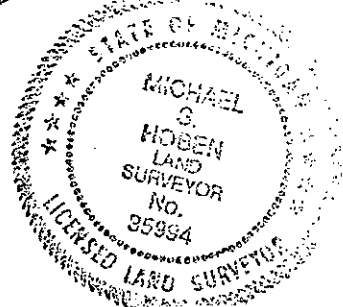

A. (Continued) Description of original monument and accessories and/or subsequent restorations:

06/22/1932	WEIKS		W.C.R.		NOT MENTIONED
1	30" ELM N20 E 111.51'				
2	5" ELM N25 W 51.9'				
06/27/1991	RICHARD	13040	ASSOCIATED ENGRS. & SURVEYORS, INC.	SURVEY	FD. 1/2" IRON REROD
3	FD. PROP COR. IRON 33' N. & 33' E, FIT DESC.				
4	QUAD ELMS N 20 W 77.07				
5	12" ELM N 40 E 43.07'				
6	ELEC. POLE S 15 E 141.32'				
7	14" ELM N 85 W 71.63'				
09/01/1992	TIETSEMA	20712	L.S.C.	SURVEY	SET 1/2" I.R. W / ATT. CAP
	I.R. set 1/2 way between the NW cor. & SW cor.				
8	18" TRI-ELM N 10 W 87.61'				
9	12" ELM N 40 E 55.55'				
12	P.P. S 10 E 130.50'				

APPROVED

DATE 12/18/94CO. REP. KA