

REMONUMENTATION

COPY

MAY - 1 1995

LAND CORNER RECORDATION CERTIFICATE

Filing Requirement of Act 74, Mich. P.A. 1970

COMMISSION

K-13 Page 1

- COPY -  
RECORDED  
WASHTENAW COUNTY, MI

FEB 1 8 54 AM '95

LEON M. HANES  
COUNTY CLERK/REGISTER  
Register of Deeds Stamp and File Number

FILED  
COPY

For corners in  
Washtenaw County  
Public Land Survey

Located in: SALINE Corner Code K-13

	T	4	S	R	5	E	
	T			R			
	T			R			
	T			R			
	T			R			
Property Controlling in Section	S			T			
Miscellaneous Property in Sec.	S			T			
	S			T			

Lot No. \_\_\_\_\_, Recorded Plat \_\_\_\_\_  
Private Claims \_\_\_\_\_

	A	B	C	D	E	F	G	H	I	J	K	L	M
2	6		5		4		3		2		1		
3													
4	7		8		9		10		11		12		
5													
6	18		17		16		15		14		13		
7													
8	19		20		21		22		23		24		
9													
10	30		29		28		27		26		25		
11													
12	31		32		33		34		35		36		
13													

Michael S. Hoben in a field survey on 06/08/1994  
I hereby certify that under requirements of P.A. 74, Michigan P.A. of 1970, the corner points mentioned in lines 1 and 2 above were in conformance with regulations and rules therefore as required in the current manual of survey instructions of the United States Department of the Interior, Bureau of Land Management, or by a decree of a Court of Law and/or that the corner points mentioned in lines 3, 4 and 5 above were in conformance with the rules of the Michigan Board of Land Surveyors or by a Decree of a Court of Law, established, re-established, monumented, re-monumented, recovered, found as expressed below.

NOTE: Not more than 4 corners, all in the same town and range, may be recorded on this certificate.

Description of original monument and accessories and/or subsequent restorations:

01/01/1819 G.L.O. SET POST  
12" ELM N15W 10 LINKS  
10" SUGAR TREE S 51W 5 LINKS

(Witnesses Continued on Back ...)

Description of corner evidence found and/or method applied in restoring or reestablishing corner:

FD. 3/4" I. PIPE IN  
CENTER OF GRAVEL  
RD.


Description of monument for corner and accessories established to perpetuate locating the position of the corner:

06/08/1994 HOBEN 35994 O.H.M. REMON  
SET W.C.R. CAP ON CORNER.  
1 P.K. NAIL WITH W.C.R. TAG ON W. SIDE B. WALNUT S40E 50.25'  
4 P.K. NAIL W/W.C.R. TAG ON N. SIDE D.E. POLE S75E 111.72'  
5 P.K. NAIL W/W.C.R. TAG ON W/S B. WALNUT S30E 77.22'  
6 P.K. NAIL W/W.C.R. TAG ON N. SIDE D.E. POLE S80W 125.22'

I conclude that after careful study of the record documentation and field observations, that this corner is accepted as the best available evidence of the position of the original corner.

Witnessed by Michael S. Hoben  
Signed by Michael S. Hoben  
Surveyor's Michigan License No. 35994  
Richard, Hiltz and McCliment, Inc. 34935 Schoolcraft Road Livonia, MI 48150

Date Dec 29 1994

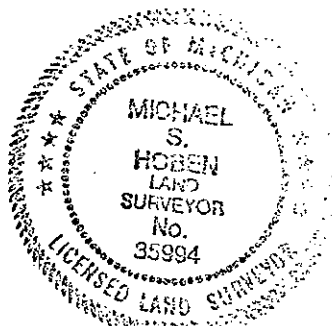

## A. (Continued) Description of original monument and accessories and/or subsequent restorations:

08/02/1982 TIETSEMA 20712 L.S.C. SURVEY F.D. 1/2" I.P.  
1 18" B. WALNUT S18E 50.25' TO NAIL  
2 ROAD SIGN S15W 20 LINKS  
3 18" HALF DEAD B. WALNUT S85W 96.61' TO NAIL  
09/01/1992 TIETSEMA 20712 L.S.C. SURVEY SET POST  
SAME AS ABOVE

APPROVED

DATE 12/13/94

CO. REP. KA