

REMON ON

COPY

MAY - 1 1995

LAND CORNER RECORDATION CERTIFICATE

Filing Requirement of Act 74, Mich. P.A. 1970

COMMISSION

L-09 Page 1

For corners in

Washtenaw

Located in: SALINE Corner Code

County

- 1. Public Land Survey T 4 S R 5 E L-09  
T \_\_\_\_\_ R \_\_\_\_\_  
T \_\_\_\_\_ R \_\_\_\_\_  
T \_\_\_\_\_ R \_\_\_\_\_
- 2. Property Controlling S \_\_\_\_\_ T \_\_\_\_\_ R \_\_\_\_\_  
in Section S \_\_\_\_\_ T \_\_\_\_\_ R \_\_\_\_\_
- 3. Miscellaneous S \_\_\_\_\_ T \_\_\_\_\_ R \_\_\_\_\_  
Property in Sec. S \_\_\_\_\_ T \_\_\_\_\_ R \_\_\_\_\_
- 4. Lot No. \_\_\_\_\_, Recorded Plat \_\_\_\_\_
- 5. Private Claims \_\_\_\_\_

LIBER 1 PAGE 370 RM  
COPY  
Register of Deeds Stamp and File Number

I, Michael S. Hoben in a field survey on 08/31/1994  
do hereby certify that under requirements of P.A. 74, Michigan P.A. of 1970, the corner points mentioned in lines 1 and 2 above were in conformance with regulations and rules therefore as required in the current manual of survey instructions of the United States Department of the Interior, Bureau of Land Management, or by a decree of a Court of Law and/or that the corner points mentioned in lines 3, 4 and 5 above were in conformance with the rules of the Michigan Board of Land Surveyors or by a Decree of a Court of Law, established, re-established, monumented, re-monumented, recovered, found as expressed below.

NOTE: Not more than 4 corners, all in the same town and range, may be recorded on this certificate.

	A	B	C	D	E	F	G	H	I	J	K	L	M
2	6	5	4	3	2	1							
3													
4	7	8	9	10	11	12							
5													
6	18	17	16	15	14	13							
7													
8	19	20	21	22	23	24							
9													
10	30	29	28	27	26	25							
11													
12	31	32	33	34	35	36							
13													

A. Description of original monument and accessories and/or subsequent restorations:

11/30/1815

G. L. O.

SET POST

ON THIS DATE  
NO WITNESSES

(Witnesses Continued on Back ...)

B. Description of corner evidence found and/or method applied in restoring or reestablishing corner:

FD. 1 1/2" IRON PIPE

C. Description of monument for corner and accessories established to perpetuate locating the position of the corner:

08/31/1994

HOBEN


35994

O.H.M.

REMON

SET W.C.R. TAG INSIDE I.P.

- 8 P.K. NAIL W/W.C.R. TAG P.P. S70E 283.26'
- 9 TOP NUT GAS MARKER S33E 82.62'
- 10 P.K. NAIL W/W.C.R. TAG P.P. S10W 77.65'
- 11 P.K. NAIL W/W.C.R. TAG P.P. S80W 299.60'

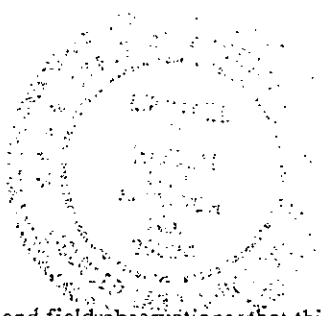

RECORDED  
WASHTENAW COUNTY, MI  
FEB 1 8 55 AM '95  
PEGGY H. HAINES  
COUNTY CLERK/REGISTER  
- COPY -

We conclude that after careful study of the record documentation and field observations, that this corner is accepted as the best available evidence of the position of the original corner.

Signed by Michael S. Hoben  
Drafted by Michael S. Hoben  
Surveyor's Michigan License No. 35994

Date Dec 29 1994

Orchard, Hiltz and McCliment, Inc. 34935 Schoolcraft Road Livonia, MI 48150

## A. (Continued) Description of original monument and accessories and/or subsequent restorations:

05/05/1936	ARMSTRONG	1244	W.C.R.C.	GRID	FD. MARK OF AN OLD STAKE. SET 1 1/2" X 40" I.P. W/STONES & BRICKS
1	8"	ELM	S76E	85.4'	
2	8"	ELM	S50E	43.6'	
3	10"	ELM	S25E	31.7'	
4	36"	MAPLE	S22W	26.3'	
5	18"	ELM	S 53W	56.6'	
6	2"	ELM	S 68W	41.5'	
7	6"	TRIPPLE	ELM	N76W	69.4'

APPROVED  
DATE ~~7/1/12~~ 10/17/12  
CO. REP. KA

2