

MAY - 1 1995

LAND CORNER RECORDATION CERTIFICATE

Filing Requirement of Act 74, Mich. P.A. 1970

COMMISSION

For corners in

Washtenaw

Located in: SALINE Corner Code

County

Public Land Survey

T 4 S R 5 E L-13

Property Controlling in Section

S T R

Miscellaneous

S T R

Property in Sec.

S T R

LIBER

1 PAGE 374 RM COPY

Register of Deeds Stamp and File Number

Lot No. Recorded Plat Private Claims

Grid table with columns A-M and rows 2-13 containing numbers 1-36.

Michael S. Hoben in a field survey on 07/20/1994 hereby certify that under requirements of P.A. 74, Michigan P.A. of 1970, the corner points mentioned in lines 1 and 2 above were in conformance with regulations and rules therefore as required in the current manual of survey instructions of the United States Department of the Interior, Bureau of Land Management, or by a decree of a Court of Law and/or that the corner points mentioned in lines 3, 4 and 5 above were in conformance with the rules of the Michigan Board of Land Surveyors or by a Decree of a Court of Law, established, re-established, monumented, re-monumented, recovered, found as expressed below.

NOTE: Not more than 4 corners, all in the same town and range, may be recorded on this certificate.

Description of original monument and accessories and/or subsequent restorations:

11/29/1915 G.L.O. SET POST 12" BEACH S 68 W 14 LINKS 18" ASH N 43 E 43 LINKS

(Witnesses Continued on Back ...)


Description of corner evidence found and/or method applied in restoring or reestablishing corner:

FD. 3/4" IRON PIPE INSIDE A 1 1/2" I. P. 6" DEEP ALSO FD. RED BRICKS AND STONES 4" DEEP.

Description of monument for corner and accessories established to perpetuate locating the position of the corner:

07/20/1994 HOBEN 35994 O.H.M. REMON. 7 P.K. NAIL W/E.C.R. TAG ON N. SIDE P.P. S 75 W 192.45' 8 P.K. NAIL W/W.C.R. TAG ON S. SIDE OF 16" BOX ELDER N 60 W 71 9 P.K. NAIL W/ W.C.R. ON S. SIDE 40" MAPLE N. 45 W 96.90' 10 P.K. NAIL W/ W.C.R. TAG ON S. SIDE N20 E 37.27' 11 SET W.C.R. CAP INSIDE IRON PIPE

RECORDED WASHTEAW COUNTY, MI FEB 1 8 55 AM '95 PEGGY M. HAIRES COUNTY CLERK/REGISTER - COPY -

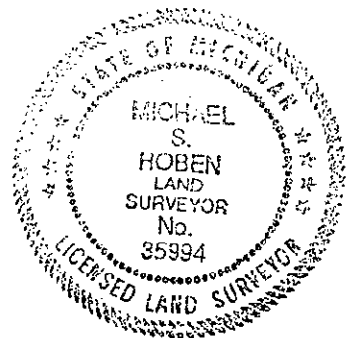

We conclude that after careful study of the record documentation and field observations, that this corner is accepted as the best available evidence of the position of the original corner.

Signed by Michael S. Hoben (signature) Drafted by Michael S. Hoben Surveyor's Michigan License No. 35994

Date Dec 29 1994

## A. (Continued) Description of original monument and accessories and/or subsequent restorations:

02/03/1933

ARMSTRONG

W.C.R.C.

FD. LARGE STONE WITH  
CHISEL MARK ON TOP  
SURROUNDED WITH SMALL  
STONES. RESET WITH 1 1/2"  
X30" IRON PIPE AND PLACED  
4 BRICKS AROUND IT.

- 1 7" CHERRY N 1 W 48.7'
- 2 24" BASSWOOD N 39 E 37.0'
- 3 6" B. ASH N 73 1/4 E 72.45'
- 4 3" HICKORY S 54 E 41.2'
- 5 6" ELM S 67 W 42.75'
- 6 2 ROW PIPES

APPROVED

DATE 0/17/94NO. REP. KA

2