

MAY - 1 1995

LAND CORNER RECORDATION CERTIFICATE
Filing Requirement of Act 74, Mich. P.A. 1970

M-09 Page 1

For corners in

Washtenaw

Located in: SALINE Corner Code

County

- 1. Public Land Survey T 4 S R 5 E M-09
- T _____ R _____
- T _____ R _____
- T _____ R _____
- 2. Property Controlling S _____ T _____ R _____
- in Section S _____ T _____ R _____
- 3. Miscellaneous S _____ T _____ R _____
- Property in Sec. S _____ T _____ R _____
- 4. Lot No. _____, Recorded Plat _____
- 5. Private Claims _____

Register of Deeds Stamp and File Number

I, Michael S. Hoben in a field survey on 06/07/1994
do hereby certify that under requirements of P.A. 74, Michigan P.A. of 1970, the corner points mentioned in lines 1 and 2 above were in conformance with regulations and rules therefore as required in the current manual of survey instructions of the United States Department of the Interior, Bureau of Land Management, or by a decree of a Court of Law and/or that the corner points mentioned in lines 3, 4 and 5 above were in conformance with the rules of the Michigan Board of Land Surveyors or by a Decree of a Court of Law, established, re-established, monumented, re-monumented, recovered, found as expressed below.

NOTE: Not more than 4 corners, all in the same town and range, may be recorded on this certificate.

	A	B	C	D	E	F	G	H	I	J	K	L	M
2	6	5	4	3	2	1							
3													
4	7	8	9	10	11	12							
5													
6	18	17	16	15	14	13							
7													
8	19	20	21	22	23	24							
9													
10	30	29	28	27	26	25							
11													
12	31	32	33	34	35	36							
13													

A. Description of original monument and accessories and/or subsequent restorations:

11/29/1815

G.L.O.

SET POST

14" ELM N11W 33 LINKS

16" ELM SS6W 27 LINKS

(Witnesses Continued on Back ...)

B. Description of corner evidence found and/or method applied in restoring or reestablishing corner:

FD. 1 1/2" I. P.

C. Description of monument for corner and accessories established to perpetuate locating the position of the corner:

06/07/1994

HOBEN

35994

O.H.M.

REMON

SET W.C.R. CAP IN 1 1/2" I.P.

10 P.K. NAIL IN W. SIDE P.P. W/W.C.R. TAG N10E 180.43'

11 P.K. NAIL W/W.C.R. TAG S/SIDE M.B.T.P. S70W 62.41'

12 P.K. NAIL W/W.C.R. TAG IN SW SIDE 20" WALNUT S40E 124.52'

13 1 1/2" I.P. SOUTH 139.01' (RECORD 139.80')

14 P.K. NAIL W/W.C.R. TAG 18" WALNUT S10W., 130.80'

We conclude that after careful study of the record documentation and field observations, that this corner is accepted as the best available evidence of the position of the original corner.

Signed by

Michael S. Hoben


Date

Dec 29 1994

Drafted by Michael S. Hoben

Surveyor's Michigan License No. 35994

Orchard, Hiltz and McCliment, Inc. 34935 Schoolcraft Road Livonia, MI 48150

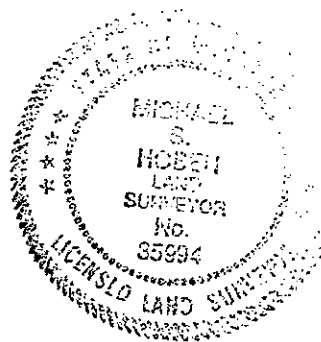

RECORDED
 WASHTEENAW COUNTY, MI
 FEB 1 8 55 AM '95
 PEGGY H. NAINES
 COUNTY CLERK/REGISTRAR
 -COPY-

A. (Continued) Description of original monument and accessories and/or subsequent restorations:

10/08/1819		G.L.O.		FD. POST
	CLOSING COR. 2.12 CH. OF POST. (139.92')			
02/02/1934	ARMSTRONG	1244	W.C.R.	FD. OLD WOOD STAKE, STONES & BRICKS, RESET WITH 1/12" I.P. WITH STONES AND BRICKS.
	1	10" ELM S25E 31.7'		
	2	36" MAPLE S22W 26.3'		
	3	18" MAPLE S53W 56.6'		
	4	2" ELM S68W 41.5'		
07/01/1973	OLIVER	19840	L.3, P	FD. 1 1/2" I.P. FROM REMAINING ACCESSORIES.
	2	46" MAPLE S22W 26.3'		
	5	14" WALNUT N80E 167.3'		
	6	M.B.T. POLE SOUTH 77.2'		
	7	STEEL F.P. NORTH 28.8'		
01/14/1980	FAHRNER	17620	W.E.C.	FD. 1 1/2" I. P.
	SAME AS ABOVE			

APPROVED

DATE 12/19/94