

MAY - 1 1995

LAND CORNER RECORDATION CERTIFICATE  
Filing Requirement of Act 74, Mich. P.A. 1970

M-12 Page 1

COMMISSION

For corners in

Washtenaw

Located in: SALINE Corner Code

County

Public Land Survey

T 4 S R 5 E M-12

Property Controlling  
in Section

S T R

Miscellaneous

S T R

Property in Sec.

S T R

Lot No. \_\_\_\_\_, Recorded Plat \_\_\_\_\_  
Private Claims \_\_\_\_\_

1 PAGE 382 RM  
COPY  
Register of Deeds Stamp and File Number

	A	B	C	D	E	F	G	H	I	J	K	L	M
2	6	5	4	3	2	1							
3													
4	7	8	9	10	11	12							
5													
6	18	17	16	15	14	13							
7													
8	19	20	21	22	23	24							
9													
10	30	29	28	27	26	25							
11													
12	31	32	33	34	35	36							
13													

Michael S. Hoben in a field survey on 06/07/1994  
I hereby certify that under requirements of P.A. 74, Michigan P.A. of 1970, the corner points mentioned in lines 1 and 2 above were in conformance with regulations and rules therefore as required in the current manual of survey instructions of the United States Department of the Interior, Bureau of Land Management, or by a decree of a Court of Law and/or that the corner points mentioned in lines 3, 4 and 5 above were in conformance with the rules of the Michigan Board of Land Surveyors or by a Decree of a Court of Law, established, re-established, monumented, re-monumented, recovered, found as expressed below.

NOTE: Not more than 4 corners, all in the same town and range, may be recorded on this certificate.

Description of original monument and accessories and/or subsequent restorations:

11/29/1815 G.L.O. set post  
4" W.O S42W 41 LINKS  
6" W.O. N20E 77 LINKS

(Witnesses Continued on Back ...)

Description of corner evidence found and/or method applied in restoring or reestablishing corner:

FD 1 1/2" IRON PIPE  
(ARMSTRONG SET 1  
1/2" I.P.)

Description of monument for corner and accessories established to perpetuate locating the position of the corner:


06/07/1994 HOBEN 35994 O.H.M. INC. REMON  
SET W.C.R. CAP IN IRON PIPE.  
1 PK NAIL WITH WCR TAG & (R) ON NW SIDE OF 26 IN BLACK W  
6 PK NAIL W/ WCR TAG ON NE SIDE OF 8 IN. BLACK WALNUT N  
7 PK NAIL W/ WCR TAG ON NE SIDE OF 8 IN. MAPLE N 65 W 33.3  
8 FOUND IRON S. 138.47', A-12 T.4S., R.6E., (M) 138.53' (R)

RECORDED  
WASHTENAW COUNTY, MI  
FEB 1 8 58 AM '95  
PEGGY N. HAINES  
COUNTY CLERK/REGISTER  
-copy-

I conclude that after careful study of the record documentation and field observations, that this corner is accepted as the best available evidence of the position of the original corner.

Witnessed by Michael S. Hoben Date Dec 29, 1994  
Sustained by Michael S. Hoben

Surveyor's Michigan License No. 35994  
Richard, Hiltz and McCliment, Inc. 34935 Schoolcraft Road Livonia, MI 48150

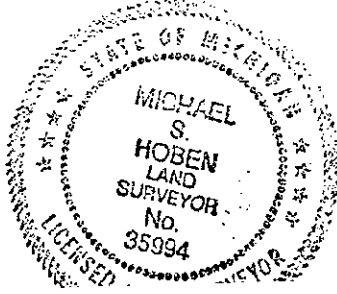

A. (Continued) Description of original monument and accessories and/or subsequent restorations:

02/03/1936 ARMSTRONG 1244 W.C.R.C.

Fd. an old wood stake and reset with 1 1/2" X 48" i.p., placed 4 bricks around it.

- 1 12" B. WALNUT N 40 E 40.4'
- 2 14" B. WALNUT S 34 E 40.08'
- 3 12" B. WALNUT S 25 W 37.1'

01/05/1943 Atwell

Fd. cor. (no witnesses)

4 TIE TO THE NE COR NORTHERLY 2644.4' (MEAS. 2644.98)

04/30/1993 JERABSON 19836

certificate dose not state what was found.

WITNESSES TAKEN ARE FOR A-12 T.4S., R.6E.,

- 6 MEAS. TO A-13 = 2,777.23'
- 7 MEAS. TO M-11 = 2,644.96'

APPROVED  
DATE 12/19/94  
CO. REP. M