

REMONUMENTATION

COPY

MAY - 1 1995

LAND CORNER RECORDATION CERTIFICATE

Filing Requirement of Act 74, Mich. P.A. 1970

COMMISSION

M-13 Page 1

For corners in

Washtenaw

Located in: SALINE Corner Code

County

- Public Land Survey T 4 S R 5 E M-13
- T \_\_\_\_\_ R \_\_\_\_\_
- T \_\_\_\_\_ R \_\_\_\_\_
- T \_\_\_\_\_ R \_\_\_\_\_
- Property Controlling S \_\_\_\_\_ T \_\_\_\_\_ R \_\_\_\_\_
- in Section S \_\_\_\_\_ T \_\_\_\_\_ R \_\_\_\_\_
- Miscellaneous S \_\_\_\_\_ T \_\_\_\_\_ R \_\_\_\_\_
- Property in Sec. S \_\_\_\_\_ T \_\_\_\_\_ R \_\_\_\_\_
- Lot No. \_\_\_\_\_, Recorded Plat \_\_\_\_\_
- Private Claims \_\_\_\_\_

LIBER 1 PAGE 384 RM COPY

Register of Deeds Stamp and File Number

	A	B	C	D	E	F	G	H	I	J	K	L	M
2	6		5		4		3		2		1		
3													
4	7		8		9		10		11		12		
5													
6	18		17		16		15		14		13		
7													
8	19		20		21		22		23		24		
9													
10	30		29		28		27		26		25		
11													
12	31		32		33		34		35		36		
13													

Michael S. Hoben in a field survey on 06/07/1994  
 do hereby certify that under requirements of P.A. 74, Michigan P.A. of 1970, the corner points mentioned in lines 1 and 2 above were in conformance with regulations and rules therefore as required in the current manual of survey instructions of the United States Department of the Interior, Bureau of Land Management, or by a decree of a Court of Law and/or that the corner points mentioned in lines 3, 4 and 5 above were in conformance with the rules of the Michigan Board of Land Surveyors or by a Decree of a Court of Law, established, re-established, nonumented, re-monumented, recovered, found as expressed below.

NOTE: Not more than 4 corners, all in the same town and range, may be recorded on this certificate.

1. Description of original monument and accessories and/or subsequent restorations:

11/29/1815 G.L.O. set post  
 12" LYNN N68E 33 LINKS  
 6" BURCH S73 W 13 LINKS

(Witnesses Continued on Back ...)

2. Description of corner evidence found and/or method applied in restoring or reestablishing corner:

FD 3/4" I.P. & left a  
 W.C.R. cap over I.P. 6"  
 DEEP

3. Description of monument for corner and accessories established to perpetuate locating the position of the corner:


06/07/1994 HOBEN 35994 O.H.M INC. REMON  
 SET W.C.R. CAP OVER I.P.  
 5 PK NAIL W/ WCR TAG ON N. SIDE S 55 W 54.33'  
 6 DE GUY POLE PK NAIL W/ WCR TAG ON N SIDE S45 E 56.58'  
 7 DE GUY POLE PK NAIL W/ WCR TAG ON E SIDE N35E 80.74'  
 9 10" OAK PK NAIL W/ WCR TAG ON S SIDE N 70 E 84.45'  
 10 MEAS. M-12 TO M-13 = 2,777.13'

RECORDED  
 WASHTEHAW COUNTY, MI  
 FEB 1 8 58 AM '95  
 PEGGY M. HAINES  
 COUNTY CLERK/REGISTER  
 -COPY-

We conclude that after careful study of the record documentation and field observations, that this corner is accepted as the best available evidence of the position of the original corner.

Signed by Michael S. Hoben Date Dec 29 1994  
 Drafted by Michael S. Hoben  
 Surveyor's Michigan License No. 35994

Richard, Hiltz and McCliment, Inc. 34935 Schoolcraft Road Livonia, MI 48150

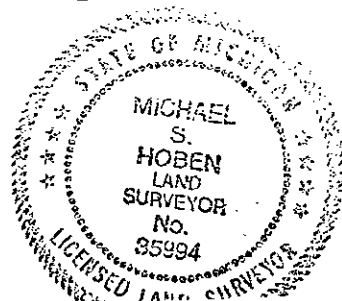

A. (Continued) Description of original monument and accessories and/or subsequent restorations:

05/05/1943	Atwell		W.C.R.C.		iron pipe
	1	14" S. MAPLE S 54 E 57.6'			
	2	14" S. MAPLE S 33 E 57.1			
	3	N.W. COR. SCHOOL S 20 E 166.4'			
02/20/1973	K. Suydam	17636	Walter Frazier & Assoc	survey	iron pipe
	2	24" MAPLE S 30 E 56.93'			
	4	18" MAPLE S 60 E 70.13'			
	5	P.P. S 70 W 53.37'			
12/01/1978	Tietsema	20712	Controle Survey Assoc.	certified	Fd. corner
	2	30" STUMP S 50 E 56.69'			
	5	P.P. S 60 W 54.55'			
	6	GUY POLE S 50 E 56.69'			
04/30/1993	JEKABSON	19836	Roskelly, Jekabson & Assoc.	certified	Dosen't state what was found.
	5	NAIL IN D.E. POLE S 70 W 54.24'			
	6	NAIL IN GUY POLE S 50 E 56.56'			
	7	P. K. GUY POLE N 30 W 80.76'			
	8	BRIDGE AHEAD SIGN N 80 W 114.5'			
	10	FROM M-12 TO M-13 = 2,777.23'			

APPROVED

DATE 12/19/94

CO. REP. KA