

**SURVEY &
REMONUMENTATION**

APPROVED

DATE 9-23-96
CO. REP. K/A

MAY 05 1997

**COMMISSION
LAND CORNER RECORDATION CERTIFICATE**
Filing Requirement of Act 74, Mich. P.A. 1970

PEGGY M. HAINES
COUNTY CLERK/REGISTER

FEB 18 9 18 AM '91

RECORDED
WASHTENAW COUNTY, MI

For corners in

WASHTENAW
(county)

Located In: Corner Code #

- | | | |
|---------------------------------------|-------------------------|------------|
| 1. Public Land Survey | T <u>4S</u> R <u>6E</u> | <u>G-9</u> |
| | T _____ R _____ | _____ |
| | T _____ R _____ | _____ |
| | T _____ R _____ | _____ |
| 2. Property Controlling
in Section | S _____ T _____ R _____ | _____ |
| | S _____ T _____ R _____ | _____ |
| 3. Miscellaneous
Property in Sec. | S _____ T _____ R _____ | _____ |
| | S _____ T _____ R _____ | _____ |

Liber 00001 Page 0654 *RM*

Register of Deeds Stamp & File Number

4. Lot No. _____, Recorded Plat _____
5. Private Claims _____

	A	B	C	D	E	F	G	H	I	J	K	L
2	6	5	4	3	2	1						
3												
4	7	8	9	10	11	12						
5												
6	18	17	16	15	14	13						
7												
8	19	20	21	22	23	24						
9												
10	30	29	28	27	26	25						
11												
12	31	32	33	34	35	36						
13												

I, PATRICK L. HASTINGS in a field survey on FEB. 29, _____, 19 96, do hereby certify that under requirements of P.A. 74, Michigan P.A. of 1970, the corner points mentioned in lines 1 and 2 above were in conformance with regulations and rules therefore as required in the current manual of survey instructions of the United States Department of the Interior, Bureau of Land Management or by a decree of a Court of Law and/or that the corner points mentioned in lines 3, 4 and 5 above were in conformance with the rules of the Michigan Board of Land Surveyors or by a Decree of a Court of Law; established, re-established, monumented, re-monumented, recovered, found as expressed below:

NOTE: Not more than 4 corners, all in the same town and range, may be recorded on this certificate.

A. Description of original monument and accessories and/or subsequent restoration:

- 1819 G.L.O. SET WOOD POST
14" BEECH N 19° E 17 LKS
14" W.O. N 12° W 26 LKS
- 1934 W.C.R.C., W.J. ARMSTRONG; SURVEYED AND RESET THIS POST WITH AN IRON PIPE SET INSIDE A 5" TILE WITH STONE AND BRICKS AROUND IT.
(1) B. WALNUT 12" N 84° W 301.5
(2) W. CHERRY 4" N 30 1/2° E 27.0
(3) WHITE OAK 20" N 78° E 127.1
(4) 2 R. OF W. PIPES

(CONTINUED ON BACK)


B. Description of corner evidence found and/or method applied in restoring or reestablishing corner:

- 1996 FOUND 2" IRON PIPE SET INSIDE OF A CLAY TILE LOCATED APPROXIMATELY 8' SOUTH OF THE NORTH EDGE OF AN E-W GRAVEL ROAD.
(5) 32" POPLAR N 40° W 25.25
(6) POWER POLE S 50° E 70.89
(7) 70" WILLOW N 43° W 152.40
(8) 48" BOXELDER NORTH 145.50
(9) S.E. CORNER METAL BARN N 20° W 59.00
(10) 8" TWIN BOXELDER SOUTH 62.60
(11) BIRD HOUSE POLE N 65° W 93.66

C. Description of monument for corner and accessories established to perpetuate locating the position of the corner:

- AFTER A CAREFUL STUDY OF THE RECORD DOCUMENTATION AND FIELD OBSERVATIONS, MADE UNDER MY DIRECT SUPERVISION, I FIND THIS CORNER TO BE A CAREFUL AND FAITHFUL PERPETUATION OF THE POSITION OF THE ORIGINAL CORNER. THE EXISTING 2" IRON PIPE WAS TOPPED WITH A NAIL AND 1 1/2" WASHER STAMPED "WASHTENAW CO. ROAD COMM."
(5) 32" POPLAR N 40° W 25.25 PK/RT
(6) POWER POLE S 50° E 70.89 PK/RT
(7) 70" WILLOW N 43° W 152.40
(8) 48" BOXELDER NORTH 145.50
(9) S.E. CORNER METAL BARN N 20° W 59.00
(10) 8" TWIN BOXELDER SOUTH 62.60 PK/RT
(11) BIRD HOUSE POLE N 65° W 93.66

Signed by *Patrick L. Hastings* Date 10/28/96
Surveyor's Michigan License No. 37277

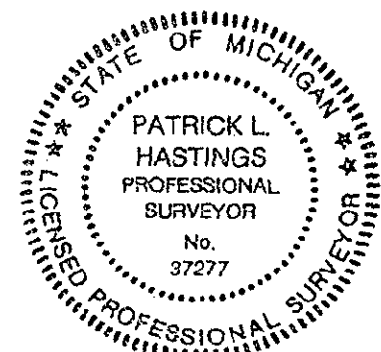

COPY

1978 SURVEY BY MIDWESTERN CONSULTING, ALLEN R. RENTSCHLER, P.S.# 15411, JOB NO. 78332

FOUND 2" IRON

- (5) 18" POPLAR N 40° W 25.5
- (6) UTILITY POLE S 60° E 70.8
- (7) 30" WILLOW N 50° W 153.0

1978 L.C.R.C. BY ATWELL-HICKS, ROBERT J. JAGOW, P.S.# 6998, LIBER 5, PG. 55

FOUND 2" IRON PIPE

- (5) 28" POPLAR N 40° W 25.5
- (6) POWER POLE N 50° E 70.8 (SEE ABOVE #6 S 60° E)
- (7) 40" WILLOW N 43° W 152.4
- (8) 32" BOX ELDER NORTH 145.5

1995 SURVEY BY WASHTENAW ENGINEERING, THOMAS SUTHERLAND, P.S.# 24620, JOB NO. 25451

FOUND 2" IRON PIPE

- (5) 26" POPLAR N 40° W 25.23 TO NAIL
- (6) POWER POLE S 50° E 70.89 TO NAIL
- (9) SE CORNER METAL BARN N 20° W 59.00
- (10) 8" TWIN BOX ELDER SOUTH 62.60 TO NAIL
- (11) BIRD HOUSE POLE N 65° W 93.66