

APPROVED

DATE 9-23-96

CO. REF. K2

LAND CORNER RECORDATION CERTIFICATE
Filing Requirement of Act 74, Mich. P.A. 1970

For corners in

WASHTENAW
(county)

Located In:

Corner Code #

- 1. Public Land Survey T 4S R 6E G-10
T _____ R _____
T _____ R _____
T _____ R _____
- 2. Property Controlling S _____ T _____ R _____
in Section S _____ T _____ R _____
- 3. Miscellaneous S _____ T _____ R _____
Property In Sec. S _____ T _____ R _____

- 4. Lot No. _____, Recorded Plat _____
- 5. Private Claims _____

I, Patrick L. Hastings, in a field survey on Feb. 29, 19 96, do hereby certify that under requirements of P.A. 74, Michigan P.A. of 1970, the corner points mentioned in lines 1 and 2 above were in conformance with regulations and rules therefore as required in the current manual of survey instructions of the United States Department of the Interior, Bureau of Land Management or by a decree of a Court of Law and/or that the corner points mentioned in lines 3, 4 and 5 above were in conformance with the rules of the Michigan Board of Land Surveyors or by a Decree of a Court of Law; established, re-established, monumented, re-monumented, recovered, found as expressed below:

NOTE: Not more than 4 corners, all in the same town and range, may be recorded on this certificate.

A. Description of original monument and accessories and/or subsequent restoration:

- 1819 G.L.O. SET WOOD POST
- 10" ASH N 65° W 12 LKS
- 6" ASH S 45° E 7 LKS

NOTE: NO INFORMATION FOUND IN GRID BOOK.

(CONTINUED ON BACK)

B. Description of corner evidence found and/or method applied in restoring or reestablishing corner:

- 1996 FOUND 3/4" IRON PIPE, PULLED IRON AND DUG TO A DEPTH OF 1.5 FEET AND FOUND NO OTHER EVIDENCE
- 1) 30" CLUSTER MAPLE S 10° W 12.54'
- 2) 8" PINE S 85° E 23.4'
- 3) DEAD 16" ELM S 80° E 23.4
- 5) 12" CEDAR N 85° W 18.23

C. Description of monument for corner and accessories established to perpetuate locating the position of the corner:

AFTER A CAREFUL STUDY OF THE RECORD DOCUMENTATION AND FIELD OBSERVATIONS, MADE UNDER MY DIRECT SUPERVISION, I FIND THIS CORNER TO BE A CAREFUL AND FAITHFUL REESTABLISHMENT OF THE POSITION OF THE ORIGINAL CORNER. SET STANDARD REMON. CAP ON 3/4" IRON PIPE STAMPED 37277

- 1) 30" CLUSTER MAPLE S 10° W 12.54' PK/RT
- 2) 8" PINE S 85° E 23.4' PK/RT
- 3) DEAD 16" ELM S 80° E 23.4 PK/RT
- 5) 12" CEDAR N 85° W 18.23 PK/RT

COPY

Signed by Patrick L. Hastings
Surveyor's Michigan License No. 37277

Date 10/28/96

RECORDED
WASHTENAW COUNTY, MI
FEB 18 9 18 AM '97
PEGGY M. HAINES
COUNTY CLERK/REGISTRAR

Liber 00001 Page 0652 RM


Register of Deeds Stamp & File Number

	A	B	C	D	E	F	G	H	I	J	K	L
2	6		5		4		3		2		1	
3												
4	7		8		9		10		11		12	
5												
6	18		17		16		15		14		13	
7												
8	19		20		21		22		23		24	
9												
10	30		29		28		27		26		25	
11												
12	31		32		33		34		35		36	
13												

SURVEY &
REMONUMENTATION

MAY 05 1997

COMMISSION

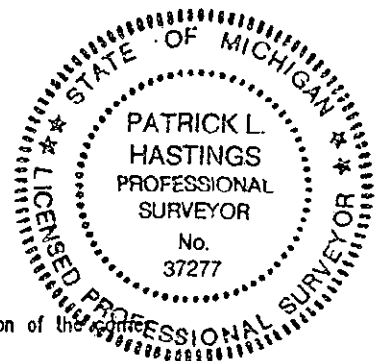

1978 L.C.R.C. BY ATWELL-HICKS, ROBERT J. JAGOW, P.S. #6998, LIBER 5, PG. 55
FOUND NOTHING, SET 3/4"X18" IRON PIPE AT MIDPOINT ON STRAIGHT LINE
BETWEEN NE COR. SEC. AND SE. COR. SECTION.

- (1) 22" CLUSTER MAPLE S 10° W 12.8
- (2) 8" PINE S 85° W 3.7
- (3) 6" ELM S 80° E 23.5
- (4) 8" PINE WEST 11.9
- (5) 10" CEDAR N 85° W 18.3

Y 400