

APPROVED

DATE 9-23-96

CO. REF. KA

LAND CORNER RECORDATION CERTIFICATE
Filing Requirement of Act 74, Mich. P.A. 1970

RECORDED
WASHTENAW COUNTY, MI
FEB 18 - 9 18 AM '97
PEGGY M. HAINES
COUNTY CLERK/REGISTER

For corners in

WASHTENAW
(county)

Located In: Corner Code #

- 1. Public Land Survey T 4S R 6E G-11
T _____ R _____
T _____ R _____
T _____ R _____
- 2. Property Controlling S _____ T _____ R _____
in Section S _____ T _____ R _____
- 3. Miscellaneous S _____ T _____ R _____
Property in Sec. S _____ T _____ R _____

Liber 00001 Page 0650 *RM*
Register of Deeds Stamp & File Number

- 4. Lot No. _____, Recorded Plat _____
- 5. Private Claims _____

I, PATRICK L. HASTINGS, in a field survey on FEB. 29, 19 96, do hereby certify that under requirements of P.A. 74, Michigan P.A. of 1970, the corner points mentioned in lines 1 and 2 above were in conformance with regulations and rules therefore as required in the current manual of survey instructions of the United States Department of the Interior, Bureau of Land Management or by a decree of a Court of Law and/or that the corner points mentioned in lines 3, 4 and 5 above were in conformance with the rules of the Michigan Board of Land Surveyors or by a Decree of a Court of Law; established, re-established, monumented, re-monumented, recovered, found as expressed below:

NOTE: Not more than 4 corners, all in the same town and range, may be recorded on this certificate.

A. Description of original monument and accessories and/or subsequent restoration:

- 1819 G.L.O. SET WOOD POST
10" BEECH N 46° E 11 LKS
10" OAK S 72° W 10 LKS


- NO DATE GRIDBOOK, H.H. ATWELL, IRON PIPE
(1) MAPLE 20" SOUTH 81.6
(2) B. OAK 36" S. OF W. 35.5
(3) WALNUT 16" N.E. 37.7
(4) WALNUT 8" NORTH 85.5
(CONTINUED ON BACK)

B. Description of corner evidence found and/or method applied in restoring or reestablishing corner:

- 1996 FOUND BOAT SPIKE DRIVEN DOWN TOP OF 1" IRON PIPE, SLIGHTLY BELOW GRADE, NEXT TO 1 1/2" ANGLE IRON. FOUND 1/2" IRON ROD, APPROXIMATELY 2" ABOVE GRADE, 0.2' NORTH AND 0.2' EAST OF 1" IRON PIPE WITH BOAT SPIKE. ALSO FOUND AXLE SHAFT APPROXIMATELY 0.3' NORTH OF 1" IRON PIPE WITH BOAT SPIKE, PROTRUDING SEVERAL FEET ABOVE GRADE. REMOVED ABOVE MENTIONED 1/2" IRON ROD, 1 1/2" ANGLE IRON, AND AXLE SHAFT DURING EXCAVATION OF 1" IRON PIPE AND BOAT SPIKE.
(5) P.K. NAIL WEST FACE UTILITY POLE N 5° E 65.70
(6) P.K. NAIL EAST FACE UTILITY POLE S 5° E 14.55
(7) NW. CORNER GARAGE S 5° E 79.55
(8) NE. CORNER GARAGE S 15° E 83.80
(11) P.K. NAIL NORTH FACE 14" APPLE WEST 54.58
(12) P.K. NAIL NORTH FACE 20" HACKBERRY EAST 52.10

C. Description of monument for corner and accessories established to perpetuate locating the position of the corner.


- AFTER A CAREFUL STUDY OF THE RECORD DOCUMENTATION AND FIELD OBSERVATIONS, MADE UNDER MY DIRECT SUPERVISION, I FIND THIS CORNER AS REMONUMENTED TO BE THE BEST AVAILABLE EVIDENCE OF THE POSITION OF THE ORIGINAL CORNER. RESET WITH 1" x 24" IRON PIPE AND ROMONUMENTATION CAP STAMPED #37277.
- (5) P.K. NAIL WEST FACE UTILITY POLE N 5° E 65.70
(6) P.K. NAIL EAST FACE UTILITY POLE S 5° E 14.55
(7) NW. CORNER GARAGE S 5° E 79.55
(8) NE. CORNER GARAGE S 15° E 83.80
(11) P.K. NAIL NORTH FACE 14" APPLE WEST 54.58
(12) P.K. NAIL NORTH FACE 20" HACKBERRY EAST 52.10

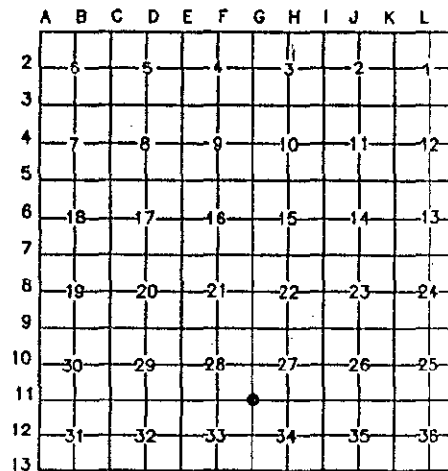

SURVEY & REMONUMENTATION

MAY 05 1997

COMMISSION

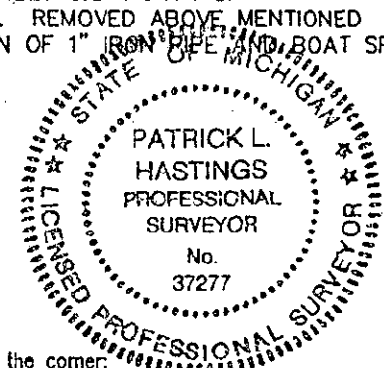

COPY

Signed by Patrick L. Hastings

Date 10/28/96

Surveyor's Michigan License No. 37277

- 1966 SURVEY BY WASHTENAW ENGINEERING, SHOWS SECTION CORNER AS F.I.P., AND NOTES SET SPIKE ON C/L MOOREVILLE ROAD 539.48' WEST OF SECTION CORNER. NO WITNESSES.
- 1966 SURVEY BY WASHTENAW ENGINEERING, SHOWS SECTION CORNER AS F.I.P., AND NOTES SET SPIKE ON C/L MOOREVILLE ROAD 539.48' WEST OF SECTION CORNER. NO WITNESSES.
- 1968 SURVEY BY WASHTENAW ENGINEERING, SHOWS F.I.P., NO WITNESSES.
- 1968 SURVEY BY WASHTENAW ENGINEERING, SHOWS SYMBOL AT CORNER. DOES NOT INDICATE AS FOUND. NO WITNESSES.
- 1969 SURVEY BY WASHTENAW ENGINEERING, SHOWS S.I.P., NO WITNESSES.
- 1971 SURVEY BY ATWELL-HICKS, JOHN LITCHFIELD SNYDER, P.S. #13352, LIBER 1370, PG. 383
FOUND IRON PIPE.
(3) BURNED STUMP N 75° E 37.7
(5) POWER POLE N 5° E 65.9
(6) POWER POLE S 5° E 14.3
(7) NW. COR. GARAGE S 5° E 79.3
(8) NE. COR. GARAGE S 15° E 83.8
- 1972 SURVEY BY WASHTENAW ENGINEERING, NORMAN N. FAHRNER, P.S. #17620, LIBER 1412, PG. 412
FOUND 3/4" IRON PIPE.
(1) STUMP SOUTH 81.6
(3) STUMP N.E. 37.7
(5) POWER POLE N 5° E 66.0
(6) POWER POLE S 5° E 14.5
(9) 8" TRI-APPLE S 35° W 55.0
(10) 6" CHERRY S 85° W 28.0
- 1973 L.C.R.C. BY WASHTENAW ENGINEERING, NORMAN N. FAHRNER, P.S. #17620, LIBER 2, PG. 237
FOUND 3/4" IRON PIPE
(1) STUMP SOUTH 81.6
(3) STUMP N.E. 37.7
(5) POWER POLE N 5° E 66.0
(6) POWER POLE S 5° E 14.5
(9) 8" TRI-APPLE S 35° W 55.0
(10) 6" CHERRY S 85° W 28.0
- 1980 L.C.R.C. BY PAUL V. SCHWIMMER, P.S. #24618, LIBER 5, PG. 289
FOUND BOLT SPIKE IN IRON PIPE NEXT TO 1 1/2" ANGLE IRON.
(5) POWER POLE N 5° E 65.9
(6) POWER POLE S 5° E 14.4
(7) NW. COR. GARAGE S 5° E 79.3
(8) NE. COR. GARAGE S 15° E 83.8
(11) 14" APPLE S 85° W 54.7
- 1982 SURVEY BY PLANNING, ENGINEERING, DESIGN & LAYOUT, INC., RICHARD L. MERRY P.S. #19790
FOUND 3/4" IRON PIPE AND ANGLE IRON AT SW. COR. SEC. 27, T4S, R6E, COR. IS RECORDED IN LIBER 2, PG. 237 AND LIBER 5, PG. 289, WASHTENAW CO. RECORDS. NO WITNESSES GIVEN.
- 1984 SURVEY BY WALTER E. FRAZIER & ASSOC., KENNETH L. SUYDAM, P.S. #17636
NO INDICATION AS TO WHAT WAS FOUND.
(1) STUMP SOUTH 81.6
(3) STUMP NE. 37.7
(5) POWER POLE N 5° E 66.0
(6) POWER POLE S 5° E 14.5
(9) 8" APPLE S 35° W 55.0
- 1985 SURVEY BY WALTER E. FRAZIER & ASSOC., KENNETH L. SUYDAM, P.S. #17636
NO INDICATION AS TO WHAT WAS FOUND.
(11) 12" APPLE WEST 55.0
(12) 4" HACKBERRY EAST 52.0
- 1988 SURVEY BY ATWELL-HICKS, ROBERT G. MACOMBER, P.S. #27453, JOB NO. 37613
FOUND IRON PIPE.
(3) BURNED STUMP N 75° E 37.7
(5) POWER POLE N 5° E 65.9
(6) POWER POLE S 5° E 14.3
(7) NW. COR. GARAGE S 5° E 79.3
(8) NE. COR. GARAGE S 15° E 83.8
- 1988 SURVEY BY ATWELL-HICKS, ROBERT H. HARRIS, P.S. #25846, JOB NO. 37737
FOUND IRON PIPE
(3) BURNED STUMP N 75° E 37.7
(5) POWER POLE N 5° E 65.9
(6) POWER POLE S 5° E 14.3
(7) NW. COR. GARAGE S 5° E 79.3
(8) NE. COR. GARAGE S 15° E 83.8
- 1989 SURVEY BY LAND SURVEYING CONSULTANTS, R. TIMOTHY TIETSEMA, P.S. #20712, JOB NO. 06888-4S6E34
FOUND 1" IRON PIPE
(5) POWER POLE N 5° E 65.90
(7) NW. COR. GARAGE S 5° E 79.30
(8) NE. COR. GARAGE S 15° E 83.80
(12) 12" POPLAR S 87° E 52.20
- 1994 SURVEY BY LAND SURVEYING CONSULTANTS, R. TIMOTHY TIETSEMA, P.S. #20712, JOB NO. 13594-4S6E34
FOUND 1/2" IRON ROD
(6) POWER POLE S 8° E 14.25
(7) NW. COR. GARAGE S 5° E 79.30
(11) 15" APPLE S 85° W 53.91
(13) 18" CHERRY EAST 51.12

W.M.

1966
1966
1968
1968
1969
1971
1972
1973
1980
1982
1984
1985
1988
1988
1989
1994