

APPROVED

DATE 9-23-96

CO. REP. Ky

LAND CORNER RECORDATION CERTIFICATE  
Filing Requirement of Act 74, Mich. P.A. 1970

RECORDED  
WASHTENAW COUNTY, MI  
FEB 18 9 17 AM '97  
PEGGY R. HAINES  
COUNTY CLERK/REGISTER

For corners in

	WASHTENAW (county)	Located In:	Corner Code #
1. Public Land Survey		T <u>4S</u> R <u>6E</u>	<u>G-12</u>
		T _____ R _____	_____
		T _____ R _____	_____
		T _____ R _____	_____
2. Property Controlling in Section	S _____	T _____ R _____	_____
	S _____	T _____ R _____	_____
3. Miscellaneous Property in Sec.	S _____	T _____ R _____	_____
	S _____	T _____ R _____	_____

Liber 00001 Page 0648 RM

Register of Deeds Stamp & File Number

- 4. Lot No. \_\_\_\_\_, Recorded Plat \_\_\_\_\_
- 5. Private Claims \_\_\_\_\_

I, PATRICK L. HASTINGS, in a field survey on FEB. 29, 1996, do hereby certify that under requirements of P.A. 74, Michigan P.A. of 1970, the corner points mentioned in lines 1 and 2 above were in conformance with regulations and rules therefore as required in the current manual of survey instructions of the United States Department of the Interior, Bureau of Land Management or by a decree of a Court of Law and/or that the corner points mentioned in lines 3, 4 and 5 above were in conformance with the rules of the Michigan Board of Land Surveyors or by a Decree of a Court of Law; established, re-established, monumented, re-monumented, recovered, found as expressed below:

NOTE: Not more than 4 corners, all in the same town and range, may be recorded on this certificate.

A. Description of original monument and accessories and/or subsequent restoration:

- 1819 G.L.O. SET WOOD POST  
12" BEECH NORTH 6 LKS  
20" OAK S 77° W 10 LKS
- 1960 GRIDBOOK: HANDWRITTEN FROM ATWELL-HICKS?  
(1) NW. COR. CONC. HEADWALL SW 102.9  
(2) 7" MAPLE E OF N 141.3  
(3) COR. FENCE POST EAST 23.9  
(4) NE. COR. CONC. HEADWALL SE 101.3

(CONTINUED ON BACK)

B. Description of corner evidence found and/or method applied in restoring or reestablishing corner:

- 1996 FOUND 3/4" IRON PIPE SITUATED ALONG TRAVELED CENTERLINE OF N-S ROAD AND CENTERLINE OF ROAD TO WEST.  
(2) 30" MAPLE N 10° E 140.60  
(3) WOOD COR. FENCE POST EAST 22.70  
(5) NAIL NORTH FACE UTILITY POLE WITH GUY N 75° W 84.70  
(6) SPIKE SOUTH FACE 12" HACKBERRY N 65° E 21.88  
(7) P.K. NAIL WEST FACE 24" ASH N 20° E 64.57  
(8) TELEPHONE POLE WITH GUY N 25° W 74.00 NO NAIL & TAG  
(11?) PK E/SIDE UTIL. POLE S 10° W 89.00'

C. Description of monument for corner and accessories established to perpetuate locating the position of the corner:

AFTER A CAREFUL STUDY OF THE RECORD DOCUMENTATION AND FIELD OBSERVATIONS, MADE UNDER MY DIRECT SUPERVISION, I FIND THIS CORNER AS REMONUMENTED TO BE THE BEST AVAILABLE EVIDENCE OF THE POSITION OF THE ORIGINAL CORNER. THE EXISTING 3/4" IRON PIPE WAS TOPPED WITH A ROMONUMENTATION CAP STAMPED #37277.


(CONTINUED ON BACK)

COPY

Signed by Patrick L. Hastings Date 10/28/96  
Surveyor's Michigan License No. 37277

	A	B	C	D	E	F	G	H	I	J	K	L
2	6	5	4	3	2							
3												
4	7	8	9	10	11							
5												
6	18	17	16	15	14	1						
7												
8	19	20	21	22	23	2						
9												
10	30	29	28	27	26	2						
11												
12	31	32	33	34	35	3						
13												

SURVEY &  
REMONUMENTATION  
MAY 05 1997  
COMMISSION

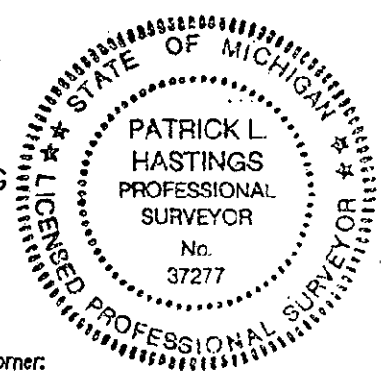

- 1967 GRIDBOOK: HANDWRITTEN NOTES FROM ??  
 FOUND 1" IRON PIN  
 (3) WOOD COR. FENCE POST EAST 22.55  
 (5) NAIL IN MBT POLE N 75° W 85.58  
 (6) NAIL IN 14" HACKBERRY N 65° E 21.87  
 (7) NAIL IN 20" ASH N 13° E 64.62  
 (8) NAIL IN TELEPHONE POLE N 15° W 73.99
- 1969 SURVEY BY WASHTENAW ENGINEERING, JOB NO. 3391 SHOWS F.I.P.  
 NO WITNESSES.
- 1970 SURVEY BY WASHTENAW ENGINEERING, JOB NO. 2195 SHOWS FOUND IRON PIN.  
 NO WITNESSES.
- 1972 L.C.R.C. BY KENNETH L. SUYDAM, P.S. #17636, LIBER 2, PG. 125  
 FOUND 1" DIAMETER IRON SHAFT APPROXIMATELY 6" BELOW SURFACE OF GRAVEL ROAD.  
 (6) NAIL AND WASHER IN 10" MT. ASH E-NE 21.77  
 (7) NAIL AND WASHER IN 16" ASH N-NE 64.20  
 (8) NAIL AND WASHER IN TELE. POLE N-NW 73.52
- 1974 SURVEY BY WALTER E. FRAZIER, KENNETH L. SUYDAM, P.S. #17636, JOB NO. 7464068  
 NO INDICATION GIVEN AS TO WHAT WAS FOUND.  
 (6) NAIL AND WASHER IN 10" MT. ASH E-NE 21.77  
 (7) NAIL AND WASHER IN 16" ASH N-NE 64.20  
 (8) NAIL AND WASHER IN TELE. POLE N-NW 73.52
- 1977 L.C.R.C. BY KENNETH L. SUYDAM, P.S. #17636, LIBER 5, PG. 39  
 FOUND 1" IRON SHAFT  
 (6) NAIL AND WASHER IN 10" MT. ASH E-NE 21.77  
 (7) NAIL AND WASHER IN 16" ASH N-NE 64.20  
 (8) NAIL AND WASHER IN TELE. POLE N-NW 73.52
- 1980 L.C.R.C. BY PAUL V. SCHWIMMER, P.S. #24618, LIBER 5, PG. 289  
 FOUND 3/4" BAR.  
 (2) 32" MAPLE N 10° E 140.4  
 (3A) ON RANGE FENCELINE E,LY  
 (6) 10" MAPLE N 80° E 22.3  
 (7) 16" ASH N 20° E 64.9  
 (8) POWER POLE N 25° W 74.1
- 1988 SURVEY BY ATWELL-HICKS, ROBERT G. MACOMBER, P.S. #27453, JOB NO. 37613  
 FOUND IRON ROD  
 (3) FENCE COR. EAST 22.0  
 (8) POWER POLE N 10° W 74.0  
 (9) 12" ELM S 45° W 34.5  
 (10) ROAD SIGN WEST 22.2
- 1988 SURVEY BY ATWELL-HICKS, ROBERT H. HARRIS, P.S. #25846, JOB NO. 37737  
 FOUND IRON PIPE  
 (3) FENCE COR. EAST 22.0  
 (8) POWER POLE N 10° W 74.0  
 (9) 12" ELM S 45° W 34.5  
 (10) ROAD SIGN WEST 22.2
- 1994 SURVEY BY WASHTENAW ENGINEERING, NORMAN N. FAHRNER, P.S. #17620, JOB NO. 24939  
 INDICATES THE CORNER AS BEING FOUND, NO WITNESSES.
- 1992 SURVEY BY LAND SURVEYING CONSULTANTS, R. TIMOTHY TIETSEMA, P.S. #20712,  
 JOB NO. 13594-4S6E34  
 FOUND 1/2" IRON PIPE  
 (5) UTILITY POLE N 80° W 85.19  
 (6) 15" CHERRY N 75° E 21.90  
 (7) 18" CHERRY N 15° E 64.57  
 (11) UTILITY POLE S 80° W 88.99

## SECTION C CONTINUED:

- (2) 30" MAPLE N 10° E 140.60  
 (3) WOOD COR. FENCE POST EAST 22.70  
 (5) NAIL NORTH FACE UTILITY POLE WITH GUY N 75° W 84.70  
 (6) SPIKE SOUTH FACE 12" HACKBERRY N 65° E 21.88  
 (7) P.K. NAIL WEST FACE 24" ASH N 20° E 64.57  
 (8) TELEPHONE POLE WITH GUY N 25° W 74.00 SET R.T. & P.K. NAIL  
 (11) PK E/SIDE UTIL. POLE S 10° W 89.00'