

**SURVEY &
REMONUMENTATION**

APPROVED

DATE 9/23/96

CO. REP. K

MAY 05 1997

LAND CORNER RECORDATION CERTIFICATE
Filing Requirement of Act 74, Mich. P.A. 1970

REGISTER
COUNTY CLERK/REGISTER

FEB 18 - 9 17 AM '97

RECORDED
WASHTENAW COUNTY, M

For corners in

WAHTENAW
(county)

Located in:

Corner Code #

- | | | |
|---------------------------------------|-------------------------|-------------|
| 1. Public Land Survey | T <u>4S</u> R <u>6E</u> | <u>G-13</u> |
| | T _____ R _____ | _____ |
| | T _____ R _____ | _____ |
| | T _____ R _____ | _____ |
| 2. Property Controlling
In Section | S _____ T _____ R _____ | _____ |
| | S _____ T _____ R _____ | _____ |
| 3. Miscellaneous
Property in Sec. | S _____ T _____ R _____ | _____ |
| | S _____ T _____ R _____ | _____ |

Liber 00001 Page 0646 *BM*

Register of Deeds Stamp & File Number

4. Lot No. _____, Recorded Plat _____
5. Private Claims _____

	A	B	C	D	E	F	G	H	I	J	K	L
2	6		5		4		3		2		1	
3												
4	7		8		9		10		11		12	
5												
6	18		17		16		15		14		13	
7												
8	19		20		21		22		23		24	
9												
10	30		29		28		27		26		25	
11												
12	31		32		33		34		35		36	
13												

I, PATRICK L. HASTINGS, in a field survey on FEB 29, 1996, do hereby certify that under requirements of P.A. 74, Michigan P.A. of 1970, the corner points mentioned in lines 1 and 2 above were in conformance with regulations and rules therefore as required in the current manual of survey instructions of the United States Department of the Interior, Bureau of Land Management or by a decree of a Court of Law and/or that the corner points mentioned in lines 3, 4 and 5 above were in conformance with the rules of the Michigan Board of Land Surveyors or by a Decree of a Court of Law; established, re-established, monumented, re-monumented, recovered, found as expressed below:

NOTE: Not more than 4 corners, all in the same town and range, may be recorded on this certificate.

A. Description of original monument and accessories and/or subsequent restoration:


1819 G.L.O. - NOT ABLE TO READ ORIGINAL NOTES. CONTACTED DEPT OF COMMERCE, THEY CHECKED THEIR COPY AND STATED THAT THEY COULD NOT READ THEIR COPY.

NOTE: OFFSET DIMENSION TO NW COR. SECTION 3, T5S, R6E IS 1.30 CHAINS (85.8') WEST OF SW COR. SECTION 34, T4S, R6E.

(CONTINUED ON BACK)

B. Description of corner evidence found and/or method applied in restoring or reestablishing corner:

- 1996 FOUND 1" x 36" IRON PIPE PINCHED AT TOP AND BOTTOM, LYING TO THE EAST AT A SEVERE HORIZONTAL ANGLE. PULLED IRON & FOUND NO OTHER EVIDENCE
- (4) 3' SOUTH OF E-W FENCE
 - (5) C/L TRAVELED ROADWAY WEST 43.0
 - (6) 1/2" IRON ROD WEST 94.3 FEET TO THE NW COR. SEC. 3, T5S, R6E
 - (7) P.K. NAIL SOUTH SIDE 30" ELM S 82° W 23.75
 - (8) 8" PINE S 45° W 37.75 NO NAIL AND WASHER
 - (9) 24" ELM EAST 65.80 NO NAIL AND WASHER
 - (10) GUY POLE N 12° E 143.34 NO NAIL AND WASHER

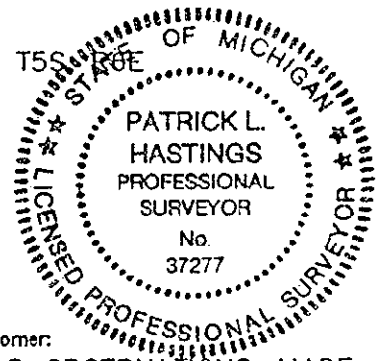

C. Description of monument for corner and accessories established to perpetuate locating the position of the corner:

AFTER A CAREFUL STUDY OF THE RECORD DOCUMENTATION AND FIELD OBSERVATIONS, MADE UNDER MY DIRECT SUPERVISION, I FIND THIS CORNER AS REMONUMENTED TO BE THE BEST AVAILABLE EVIDENCE OF THE POSITION OF THE ORIGINAL CORNER. REPLACED WITH 1" X 24" IRON PIPE AND REMONUMENTATION CAP STAMPED #37227.

- (4) 3' SOUTH OF E-W FENCE
- (5) C/L TRAVELED ROADWAY WEST 43.0
- (6) 1/2" IRON ROD WEST 94.3
- (7) P.K. NAIL SOUTH SIDE 30" ELM S 82° W 23.75
- (8) SET P.K. NAIL AND WASHER S.E. FACE 8" PINE S 45° W 37.75
- (9) SET P.K. NAIL AND WASHER S. FACE 24" ELM EAST 65.80
- (10) SET P.K. NAIL AND WASHER E. FACE GUY POLE N 12° E 143.34

COPY

Signed by Patrick L. Hastings Date 10/28/96

Surveyor's Michigan License No. 37277

1967 GRIDBOOK: HANDWRITTEN SET 1" IRON PIPE A.R.

- (1) 40" MAPLE S 42° W 174.0
- (2) 40" MAPLE WEST 114.0
- (3) 6" MAPLE S 67° W 28.0
- (4) 3' SOUTH OF EAST-WEST FENCE
- (5) C/L TRAVELED ROADWAY WEST 43.0

1970 SURVEY BY WASHTENAW ENGINEERING, JOB NO. 4448
SHOWS FOUND IRON PIPE, NO WITNESSES.