

APPROVED
 DATE 9-23-96
 CO. REP. KA

LAND CORNER RECORDATION CERTIFICATE
 Filing Requirement of Act 74, Mich. P.A. 1970

RECORDED
 WASHTENAW COUNTY, MI
 FEB 18 9 19 AM '91
 PEGGY M. HAINES
 COUNTY CLERK/REGISTRAR

For corners in

WASHTENAW (county)	Located in:	Corner Code #
1. Public Land Survey	T <u>4S</u> R <u>6E</u>	<u>H-9</u>
	T _____ R _____	_____
	T _____ R _____	_____
	T _____ R _____	_____
2. Property Controlling In Section	S _____ T _____ R _____	_____
	S _____ T _____ R _____	_____
3. Miscellaneous Property In Sec.	S _____ T _____ R _____	_____
	S _____ T _____ R _____	_____

Liber 00001 Page 0656 *RM*

Register of Deeds Stamp & File Number

4. Lot No. _____, Recorded Plat _____
 5. Private Claims _____

	A	B	C	D	E	F	G	H	I	J	K	L
2	6	5	4	3	2	1						
3												
4	7	8	9	10	11	12						
5												
6	13	17	16	15	14	13						
7												
8	19	20	21	22	23	24						
9												
10	30	29	28	27	26	25						
11												
12	31	32	33	34	35	36						
13												

I, PATRICK L HASTINGS, in a field survey on FEB. 29, 19 96, do hereby certify that under requirements of P.A. 74, Michigan P.A. of 1970, the corner points mentioned in lines 1 and 2 above were in conformance with regulations and rules therefore as required in the current manual of survey instructions of the United States Department of the Interior, Bureau of Land Management or by a decree of a Court of Law and/or that the corner points mentioned in lines 3, 4 and 5 above were in conformance with the rules of the Michigan Board of Land Surveyors or by a Decree of a Court of Law; established, re-established, monumented, re-monumented, recovered, found as expressed below:

NOTE: Not more than 4 corners, all in the same town and range, may be recorded on this certificate.

A. Description of original monument and accessories and/or subsequent restoration:
 1819 G.L.O. SET WOOD POST
 12" ASH S 17° W 9 LKS
 9" OAK N 11° E 16 LKS

SURVEY &
 REMONUMENTATION


MAY 05 1997

COMMISSION

(CONTINUED ON BACK)

B. Description of corner evidence found and/or method applied in restoring or reestablishing corner:

1996 FOUND SLIGHTLY BENT 1 1/2" IRON PIPE INSIDE OF CLAY TILE 3" BELOW SURFACE OF GRAVEL ROAD. SITUATED IN APPROXIMATE TRAVELLED C/L OF E-W ROAD.
 (8) P.K. NAIL IN N. FACE OF TELEPHONE POLE S 70° E 106.44
 (10) P.K. NAIL IN W. FACE OF 6" x 8" POST NORTH 34.33

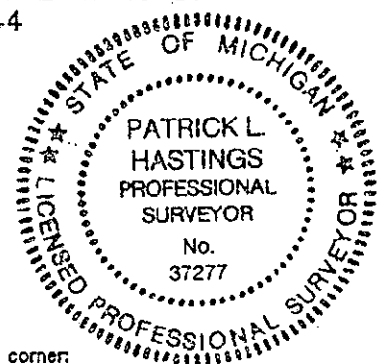

C. Description of monument for corner and accessories established to perpetuate locating the position of the corner:

AFTER A CAREFUL STUDY OF THE RECORD DOCUMENTATION AND FIELD OBSERVATIONS, MADE UNDER MY DIRECT SUPERVISION, I FIND THIS CORNER TO BE A CAREFUL AND FAITHFUL PERPETUATION OF THE POSITION OF THE ORIGINAL CORNER. THE 1 1/2" IRON PIPE WAS TOPPED WITH A NAIL AND WASHER STAMPED "WASHTENAW CO. ROAD COMM."
 (8) P.K. NAIL IN N. FACE OF TELEPHONE POLE S 70° E 106.44
 (10) P.K. NAIL IN W. FACE OF 6" x 8" POST NORTH 34.33
 (11) SET P.K. NAIL IN N. FACE OF TELEPHONE POLE S 75° W 195.22
 (12) SET P.K. NAIL/WASHER IN N. FACE OF TELEPHONE POLE S 80° E 391.00

COPY

Signed by Patrick L. Hastings Date 10/28/96
 Surveyor's Michigan License No. 37277

- 1934 W.C.R.C. W.J. ARMSTRONG; FOUND AN OLD WOOD STAKE. RESET WITH A 1 1/2" X 36" IRON PIPE INSIDE A TILE SURROUNDED WITH STONES AND BRICKS.
- (1) ELM 30" N 79° W 185.0
 - (2) ELM 2" N 78 1/2° W 133.2
 - (3) ELM 2" N 78° W 125.5
 - (4) ELM 2" N 76° W 106.9
 - (5) ELM 3" N 75° W 93.3
 - (6) ELM 18" N 22° E 24.3
 - (7) 2 R. OF W. PIPES
- 1989 SURVEY BY ATWELL-HICKS, ROBERT G. MACOMBER, P.S. #27453, LIBER 2374, PG. 582-583 FOUND 1 1/2" I.P.-SLIGHTLY BENT.
- (8) PK NAIL IN N. FACE OF T.P. S 70° E 106.42
 - (9) PK NAIL IN S. FACE OF 10" ELM N 75° E 115.32
 - (10) PK NAIL IN W. FACE OF 6"X18" POST NORTH 34.36