

REMONUMENTATION

MAY 1 1995
 COMMISSION

LAND CORNER RECORDATION CERTIFICATE
 Filing Requirement of Act 74, Mich. P.A. 1970

For corners in

Washtenaw
 (County)

Located In:

Corner Code #

1. Public Land Survey	T	4S	R	6E	I-13
	T		R		
	T		R		
	T		R		
2. Property Controlling in Section	S		T	R	
	S		T	R	
3. Miscellaneous Property in Sec.	S		T	R	
	S		T	R	

4. Lot No. _____, Recorded Plat _____
 5. Private Claims _____

REGISTERED
 WASHTEENAW COUNTY, MI
 SEP 21 11 18 AM '94
 REGISTERS
 COUNTY CLERK/REGISTER
 COPY
 LIBER 1 PAGE 49RM
 - COPY
 Register of Deeds Stamp & File Number

I, Patrick Hastings, in a field survey on December 20, 19 93, do hereby certify that under requirements of P.A. 74, Michigan P.A. of 1970, the corner points mentioned in lines 1 and 2 above were in conformance with regulations and rules therefore as required in the current manual of survey instructions of the United States Department of the Interior, Bureau of Land Management or by a decree of a Court of Law and/or that the corner points mentioned in lines 3, 4 and 5 above were in conformance with the rules of the Michigan Board of Land Surveyors or by a Decree of a Court of Law; established, re-established, monumented, re-monumented, recovered, found as expressed below:

A	B	C	D	E	F	G	H	I	J	K	L
2	6	5	4	3	2	1					
3											
4	7	8	9	10	11	12					
5											
6	18	17	16	15	14	13					
7											
8	19	20	21	22	23	24					
9											
10	30	29	28	27	26	25					
11											
12	31	32	33	34	35	36					
13											

NOTE: Not more than 4 corners, all in the same town and range, may be recorded on this certificate.

A. Description of original monument and accessories and/or subsequent restoration:

- 1815 D.S., G.L.O. Survey town line's south boundary set post.
 N 09° W 12 lks 18" Elm
 S 63° E 6 lks 8" Lynn
- 1918 G.L.O. Subdivision Notes by Francis

CONTINUED ON BACK

B. Description of corner evidence found and/or method applied in restoring or reestablishing corner:

- 1993 Remon work - found chiseled "X" in concrete walk. Our survey found this to fit location as recorded in Riverside Subdivision L.11, Pg. 52, and Riverside Subdivision No. 2, L. 12, pg. 31. Found one remaining Armstrong witness.
- (3) N.E. by E. 34.6' 12" Ash
 (10) S 73° W 66.5' 24" Maple, Fd 20 P nail

C. Description of monument for corner and accessories established to perpetuate locating the position of the corner:

After a careful study of the record documentation and field observations, made under my direct supervision, I find this corner as remonumented to be careful and faithful reestablishment of the position of the original corner.


Chiseled "X" in concrete walk.

CONTINUED ON BACK

Signed by Patrick L. Hastings

Date 8/30/94

Surveyor's Michigan License No. 37277

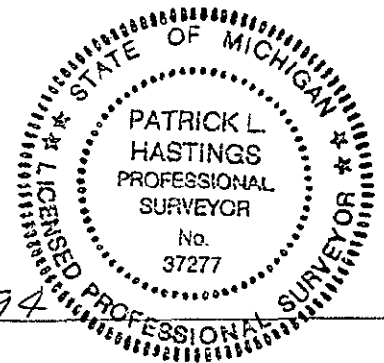

SECTION 'A' CONTINUED

1934 WCRC Gridbook by F. Colburn for C.W.A.
 (1) N. by E. 19.5' 5" Elm
 (2) N'Ely. 16.0' 6" Elm
 (3) N.E. by E. 34.6' 12" Ash
 (4) South 13.1' 8" Elm
 (5) N.W.'ly 9.9' 5" Elm

1953 Riverside Subdivision L. 11, pg. 52
 (6) N 01° 05' 20" E 1962.26' P.O.B. of Plat

1954 Riverside Subdivision No. 2, L.12, Pg. 31
 (7) N 01° 05' 20" E 497.25' P.O.B. of Plat
 (10) 30" Oak S 87° W 68.9' #10 (error in bearing)
 27" Maple S 40° W 97.6' Now Gone

1969 W.C.R.C. Gridbook by J.S., H.J., D.E., J.K.
 (8) N 67° W 67.6' To center (not legible)
 (9) N 85° W 68.73' 20" Elm, to nail
 (10) S 73° W 66.41' 10" , to nail
 * (3) N 86° E 34.0' Ash, to nail

1979 Survey by Wash. Eng. Co. Recovered corner. Noted as: F-CHISEL "X" in conc.

1990 Survey by S. Blanchard shows corner as "set P.K."
 Oct. 13

SECTION 'C' CONTINUED

(3)	N 84° E	34.61'	24" Ash, RT & PK
(6)	N 01° 05' 20" E	1962.26'	P.O.B. of Plat & by my survey
(7)	N 01° 05' 20" E	497.25'	P.O.B. of Plat & by my survey
(9)	N 88° 30' W	68.57'	24" Maple F. nail, set RT & PK
(10)	S 73° W	66.5'	24" Maple, Pd 20 P nail
(11)	N 67° 30' E	15.21'	S.E. cor. wing wall
(12)	N 73° E	3.18'	3/4" I.P. #17620, N.N.F.
(13)	S 7° 30' E	38.01'	P.P. F. PK; set RT & PK
(14)	N 89° 41' 30" W	33.03'	1/2" iron rod and cap #27446
(15)	N 87° 58' 28" W	30.09'	3/4" iron pipe, no cap
(16)	S 60° W	159.88'	N.W. cor. block foundation wall of house

Note:

Chiseled "X" in concrete walk to be monumented properly during re-construction of sidewalk by City of Milan at a later date.

APPROVED

DATE 5/3/94

NO. REP. K