

REMONUMENTATION

MAY - 1 1995

LAND CORNER RECORDATION CERTIFICATE
Filing Requirement of Act 74, Mich. P.A. 1970

For corners in COMMISSION

WASHTENAW (County)	Located in:	Corner Code #:
1. Public Land Survey	T 4S R 6E	L-9
	T _____ R _____	_____
	T _____ R _____	_____
	T _____ R _____	_____
2. Property Controlling in Section	S _____ T _____ R _____	_____
	S _____ T _____ R _____	_____
3. Miscellaneous Property in Sec.	S _____ T _____ R _____	_____
	S _____ T _____ R _____	_____
4. Lot No. _____, Recorded Plat _____		
5. Private Claims _____		

RECORDED
 WASHTENAW COUNTY, MI
 SEP 21 11 20 AM '94
 FERRY H. HAINES
 COUNTY CLERK/REGISTER

LIBER 1 PAGE 66 Rm
 - COPY -
 Register of Deeds Stamp & File Number

A	B	C	D	E	F	G	H	I	J	K	L
2	6	5	4	3	2	1					
3											
4	7	8	9	10	11	12					
5											
6	18	17	16	15	14	13					
7											
8	19	20	21	22	23	24					
9											
10	30	29	28	27	26	25					
11											
12	31	32	33	34	35	36					
13											

I, Patrick Hastings, in a field survey on December 23, 19 93, do hereby certify that under requirements of P.A. 74, Michigan P.A. of 1970, the corner points mentioned in lines 1 and 2 above were in conformance with regulations and rules therefore as required in the current manual of survey instructions of the United States Department of the Interior, Bureau of Land Management or by a decree of a Court of Law and/or that the corner points mentioned in lines 3, 4 and 5 above were in conformance with the rules of the Michigan Board of Land Surveyors or by a Decree of a Court of Law; established, re-established, monumented, re-monumented, recovered, found as expressed below:

NOTE: Not more than 4 corners, all in the same town and range, may be recorded on this certificate.

A. Description of original monument and accessories and/or subsequent restoration:

- 1819 Joseph Francis, D.S. Set post at 40 chains
Beech 16" S 33° W 23 lks
Beech 11" N 43° E 38 lks
- 1936 W.J. Armstrong. Found iron pipe; W.C.R.C. Gridbook
 - (1) S 79 1/2° E 90.1' 2" Elm
 - (2) S 45 1/2° E 53.1' 4" Poplar
 - (3) S 6 1/2° W 26.7' 1 1/2" Elm
 - (4) S 51° W 38.3' 2" Elm
 - (5) N 56° W 45.6' 4" Poplar

CONTINUED ON BACK

B. Description of corner evidence found and/or method applied in restoring or reestablishing corner:

- 1993 Found 5/8" rebar 1" below seal coat surface on painted centerline of Willow Road and occupation line south.
(8) North 24.97' North end of an 18" C.M.P.
Dug a hole 2' x 2' x 2'-3", at which point we found the top of the culvert. I strongly suggest that any evidence of the corner that may have been here was destroyed by placement of the culvert. We removed the 5/8" x 25" rebar and replaced it with a 1" x 24" iron pipe and the standard remon. cap, stamped 37277 in a monument box set in concrete 6" thick.


C. Description of monument for corner and accessories established to perpetuate locating the position of the corner:

After a careful study of the record documentation and field observations, made under my direct supervision, I find this corner as remonumented to be the best available evidence of the position of the original corner.

Set 1" x 24" iron pipe and standard remon cap, stamped 37277 in a mon. box.

- 1993 (8) North 24.97' North end of an 18" C.M.P.
- (9) South 30.90' Utility pole. Set R.T., east face
- (10) South 25.26' South end of an 18" C.M.P.
- S 72° E 153.44' Power pole. Set R.T., north face

CONTINUED ON BACK

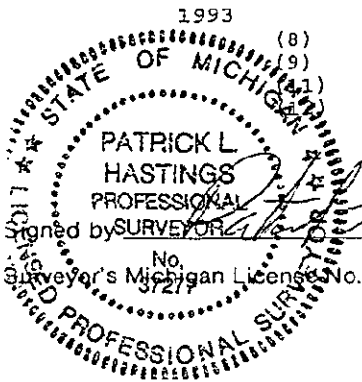

Patrick L. Hastings
 Signed by SURVEYOR
 No. 37277
 Michigan License No. 37277

Date 6/24/94

- COPY -

SECTION 'A' CONTINUED

1964		W.C.R.C. Gridbook, by R. B. Barnes	
	(6)	N.W.'ly	53.40' Nail in T. pole
	(7)	S.W.'ly	37.00' Nail in T. pole
1969		American Engineering Co. comp. sheet indicates corner was recovered.	
1972		Survey by R. Jagow; found 1/2" rod.	
	(8)	N'ly.	25.0' N. end culvert
	(9)	S'ly.	31.0' Power pole
	(10)	S 40° W	34.1' W. end culvert
1972		L.C.R.C. by R. Jagow; L.2, pg. 1, Found 1/2" rerod.	
	(8)	N'ly.	25.0' N. end culvert
	(9)	S'ly.	31.0' Power pole
	(10)	S 40° W	34.1' W. end culvert
1975		Survey by H. Taft; found 1/2" rod.	
	(8)	N'ly.	25.0' N. end culvert
	(9)	S'ly.	31.0' Power pole
	(10)	S 40° W	34.1' W. end culvert
1977		No witnesses. Survey by R. Roskelly; found iron bar.	
1985		Survey by J. Blanchard; found 1/2" rod.	
	(8)	N'ly.	25.0' N. end culvert
	(9)	S'ly.	31.0' Power pole
	(10)	S 40° W	34.1' W. end culvert

SECTION 'C' CONTINUED

1993	(13)	S 80° W	190.54'	Power pole. Set R.T., north face
	(14)	N 38° W	252.95'	Set "punch point" and painted red, in top of misplaced anchor bolt for galvanized steel grain bin. This bolt is flush with top of concrete floor/foundation of southerly of six grain bins.

APPROVED

DATE 4/15/94CO. REP. [Signature]