

REMONUMENTATION

MAY - 1 1995

LAND CORNER RECORDATION CERTIFICATE  
Filing Requirement of Act 74, Mich. P.A. 1970

For corners in  
WASHTENAW  
(County)

COMMISSION

Located In:

Corner Code #

1. Public Land Survey	T 4S R 6E	L-13
	T R	
	T R	
	T R	
2. Property Controlling in Section	S T R	
	S T R	
3. Miscellaneous Property in Sec.	S T R	
	S T R	

COPY

PERCY H. HAINES  
COUNTY CLERK/REGISTER

SEP 21 11 20 AM '94

RECORDED  
WASHTENAW COUNTY, MI

LIBER

1 PAGE

70RM

Register of Deeds Stamp & File Number

- 4. Lot No. \_\_\_\_\_, Recorded Plat \_\_\_\_\_
- 5. Private Claims \_\_\_\_\_

	A	B	C	D	E	F	G	H	I	J	K	L	M
2	6	5	4	3	2	1							
3													
4	7	8	9	10	11	12							
5													
6	18	17	16	15	14	13							
7													
8	19	20	21	22	23	24							
9													
10	30	29	28	27	26	25							
11													
12	31	32	33	34	35	36							
13													

I, Patrick Hastings, in a field survey on December, 19 93, do hereby certify that under requirements of P.A. 74, Michigan P.A. of 1970, the corner points mentioned in lines 1 and 2 above were in conformance with regulations and rules therefore as required in the current manual of survey instructions of the United States Department of the Interior, Bureau of Land Management or by a decree of a Court of Law and/or that the corner points mentioned in lines 3, 4 and 5 above were in conformance with the rules of the Michigan Board of Land Surveyors or by a Decree of a Court of Law; established, re-established, monumented, re-monumented, recovered, found as expressed below:

NOTE: Not more than 4 corners, all in the same town and range, may be recorded on this certificate.

A. Description of original monument and accessories and/or subsequent restoration:

- 1815 G.L.O. field notes: town lines, at 40 chs set post.  
Ash 15" N 71° W 26 lks  
Elm 24" S 55° E 22 lks
- 1819 G.L.O. plat by Joseph Francis, D.S.
- 1927 Plat: Milan Acres Subdivision, L.7, pg. 36 by A. J. Wenzell, C.E. Recovered corner. Noted by symbol on drawing L-13 to M-13 plat distance = 2655.96'

CONTINUED ON BACK

B. Description of corner evidence found and/or method applied in restoring or reestablishing corner:

- 1993 Found 3/4" iron pipe, pinch top, concreted in mon. box in center line of E-W road, asphalt surface. We tied the corner monument to found irons in Milan Acres Subdivision and found it to fit within 0.14' E-W over all plat distance and 0.05' N-S with existing R/W irons.  
For sections 25, 26, 35 and 36, Aug. G.L.O. chain is 66.41'  
From L-13 to M-13 2656.10' + G.L.O. chain = 66.40'

C. Description of monument for corner and accessories established to perpetuate locating the position of the corner:

After a careful study of the record documentation and field observations, made under my direct supervision, I find this corner as remonumented to be the best available evidence of the position of the original corner.

Set std. remon. cup, stamped 37277 on existing 3/4" iron pipe in mon. box.

CONTINUED ON BACK

Signed by


*Patrick L. Hastings*

Date

6/24/94

Surveyor's Michigan License No.

37277

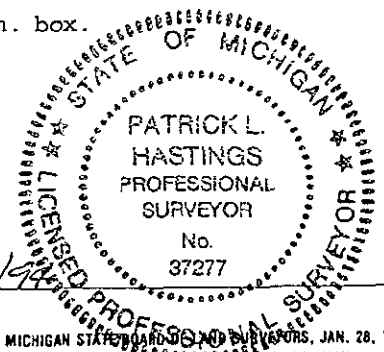

SECTION 'A' CONTINUED

LIBER 1 PAGE 71Rm  
-COPY-

1934 W.C.R.C. plat by W. J. Armstrong  
Dist. West to sec. cor. 2657.5  
Dist. East to 1/8 cor. 1328.7

Plat doesn't indicate a monument at this location.

1969 Survey by Washtenaw Engineering Job #3440. Recovered an iron pipe. Noted: F.I.P.

No Date Witnesses from Washtenaw Engineering Co. handwritten in their copy of the W.C.R.C. Grid book

- |     |                   |       |      |
|-----|-------------------|-------|------|
| (1) | U.P.              | NW'ly | 29.2 |
| (2) | Cyclone Fence Lot | N'ly  | 33.3 |
| (3) | U.P.              | S'ly  | 27.9 |
| (4) | S. End Culvert    | SW'ly | 21.4 |
| (5) | HYP               | NW'ly | 54.0 |

1972 Survey by Atwell-Hicks, Job #27923. Recovered corner. Noted: F.

1972 Survey in See 1, T5S, R6E, Job #7877. Recovered corner. Noted: F - iron rod.

SECTION 'C' CONTINUED

- |     |         |         |  |
|-----|---------|---------|--|
| (1) | North   | 33.54'  | Top of 2" dia. steel fence post.                       |
| (2) | N 75° E | 104.40' | 3/4" I.P. for S.E. cor. Lot #9                         |
| (3) | S 35° E | 69.40'  | 8" Red pine, RT & PK                                   |
| (4) | S 10° W | 56.13'  | 8" Red pine, RT & PK                                   |
| (5) | N 60° W | 54.05'  | Top nut of fire hydrant                                |
| (6) | N 30° W | 29.00'  | Utility pole, RT & PK                                  |
| (7) | S 02° E | 27.47'  | Wood post next to Ma Bell box. Found PK in north fence |

APPROVED

DATE 5/3/99

CO. REP. K