

REMONUMENTATION

MAY - 1 1995

LAND CORNER RECORDATION CERTIFICATE
Filing Requirement of Act 74, Mich. P.A. 1970

For corners in

COMMISSION

WASHTENAW

(County)

Located In:

Corner Code #

1. Public Land Survey	T	4S	R	6E	M-10
	T		R		
	T		R		
	T		R		
2. Property Controlling in Section	S		T	R	
	S		T	R	
3. Miscellaneous Property in Sec.	S		T	R	
	S		T	R	

4. Lot No. _____, Recorded Plat _____
5. Private Claims _____

RECORDED
WASHTENAW COUNTY, MI

SEP 21 11 20 AM '94

PEGGY M. HAINES
COUNTY CLERK/REGISTER

COPY

1 PAGE 74Rm
-COPY-

Register of Deeds Stamp & File Number

I, Patrick Hastings, in a field survey on December, 19 93, do hereby certify that under requirements of P.A. 74, Michigan P.A. of 1970, the corner points mentioned in lines 1 and 2 above were in conformance with regulations and rules therefore as required in the current manual of survey instructions of the United States Department of the Interior, Bureau of Land Management or by a decree of a Court of Law and/or that the corner points mentioned in lines 3, 4 and 5 above were in conformance with the rules of the Michigan Board of Land Surveyors or by a Decree of a Court of Law; established, re-established, monumented, re-monumented, recovered, found as expressed below:

NOTE: Not more than 4 corners, all in the same town and range, may be recorded on this certificate.

A. Description of original monument and accessories and/or subsequent restoration:

- 1815 G.L.O. field notes. Set post at 40 chains
Sugar 20" N 10° E 26 lks
Lynn 15" S 15° W 16 lks
- 1819 G.L.O. plat by J. Francis, D.S.
- 1969 Survey computation sheet by American Engineering Co. Notes S.I.P. at corner.
From corner North to N.E. corner Sec. 25, 2657.98'
South to S.E. corner Sec. 25, 2663.46'
No witnesses

B. Description of corner evidence found and/or method applied in restoring or reestablishing corner:

- 1993 Found 7/8" x 24" solid steel bar, 1.8' south of a fence west and on an old N-S fence.
We ran a closed traverse to establish the position of the iron bar. Our error of closure was 1':37831'. We found the bar to be 0.48 east of a line between the N.E. corner and the S.E. corner of section and 1.10' north of a split.
We find that this corner monument marks the location of the reestablished 1/4 corner and that the error in measurement is acceptable to 1:5000, as required at the time it was set and that, after a careful study of the record documentation and field observations, made under my direct supervision, I find this corner as remonumented to be a careful and faithful perpetuation of the position of the original corner.

C. Description of monument for corner and accessories established to perpetuate locating the position of the corner:

After a careful study of the record documentation and field observations, made under my direct supervision, I find this corner as remonumented to be the best available evidence of the position of the original corner.


Set a 1" x 24" iron pipe and std. remon. cap stamped 37277.

CONTINUED ON BACK

Signed by Patrick L. Hastings

Date 6/24/94

Surveyor's Michigan License No. 37277

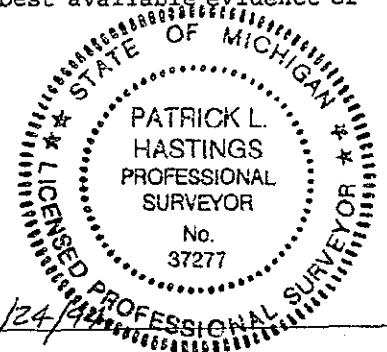

LIBER 1 PAGE 75 Rm
- COPY -

SECTION 'C' CONTINUED

(1)	N 30° W	13.80'	12" Ash, RT & PK
(2)	S 20° E	1.82'	4" Box elder, RT & PK
(3)	S 15° W	28.75'	12" Ash, RT & PK
(4)	S 25° W	19.30'	12" Elm, RT & PK
(5)	N 10° W	20.10'	8" W. Cherry, RT & PK

From Corner

North to N.E. corner Section 25, 2659.87'
South to S.E. corner Section 25, 2662.06'

APPROVED

DATE 5/3/94

CO. REP. K