

MAY - 1 1995

COMMISSION

LAND CORNER RECORDATION CERTIFICATE
Filing Requirement of Act 74, Mich. P.A. 1970

For corners in

Table with columns: WASHTENAW (County), Located in: (T 4S R 6E), Corner Code # (M-13). Rows include Public Land Survey, Property Controlling in Section, and Miscellaneous Property in Sec.

RECORDED WASHTENAW COUNTY, MI SEP 21 11 21 AM '94 PEGGY H. HAINES COUNTY CLERK/REGISTER LIBER 1 PAGE 79R1 -COPY- Register of Deeds Stamp & File Number

- 4. Lot No. , Recorded Plat
5. Private Claims

Grid table with columns A-L and rows 1-13. Numbers 1-36 are placed in the grid cells.

I, Patrick Hastings, in a field survey on December 21, 1993, do hereby certify that under requirements of P.A. 74, Michigan P.A. of 1970, the corner points mentioned in lines 1 and 2 above were in conformance with regulations and rules therefore as required in the current manual of survey instructions of the United States Department of the Interior, Bureau of Land Management or by a decree of a Court of Law and/or that the corner points mentioned in lines 3, 4 and 5 above were in conformance with the rules of the Michigan Board of Land Surveyors or by a Decree of a Court of Law; established, re-established, monumented, re-monumented, recovered, found as expressed below:

NOTE: Not more than 4 corners, all in the same town and range, may be recorded on this certificate.

A. Description of original monument and accessories and/or subsequent restoration:

- 1815 G.L.O. survey notes: Set post at 80 chains
Ash 24" S 70° W 10 lks
Lynn 9" N 54° E 21 lks
No Date W.C.R.C. Gridbook, stone
(1) North About 3' North wagon track
1927 Milan Acres Subdivision - corner of Plat

CONTINUED ON BACK

B. Description of corner evidence found and/or method applied in restoring or reestablishing corner:

- 1993 Found 3/4" iron pipe 3" below asphalt surface in good condition on occupation line north and south. Dug hole 2' x 2' x 3'-6" Found broken stone tipped over. Straightened stone and checked witnesses +/- 0.2 any direction.
(4) N 45° W 18.30' N.W. Cor. conc. headwall
(6) N 15° W 31.32' 36" Willow RT & PK
(7) N 70° W 61.3' Cottonwood stump
(8) N 45° W 67.6' 12" Scotch pine


CONTINUED ON BACK

C. Description of monument for corner and accessories established to perpetuate locating the position of the corner:

After a careful study of the record documentation and field observations, made under my direct supervision, I find this corner as remonumented to be the position of the original corner.

Set a 1" x 18" iron pipe and standard remon. cap stamped 37277 on top of stone

- (4) N 45° W 18.30' N.W. Cor. conc. headwall
(6) N 15° W 31.32' 36" Willow RT & PK
(7) N 70° W 61.3' Cottonwood stump
(8) N 45° W 67.6' 12" Scotch pine

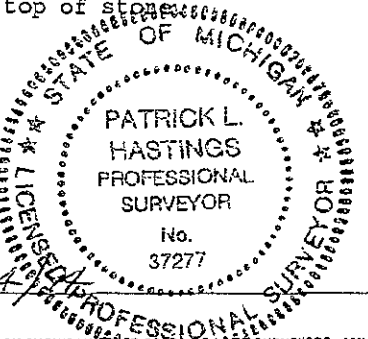

Signed by Patrick L. Hastings Date 6/24/95
Surveyor's Michigan License No. 37277

SECTION 'A' CONTINUED

1934 W.C.R.C. Plat of Section 36. No monument shown.
 West 2657.4' to S 1/4 cor. of sec.
 West 1328.7' to 1/16 corner.

1947 Survey by Angelo Marion, corner shown on survey.

No Date Survey by Walter E. Frazier & Associates. Corner shown on survey
 (2) N 5° W 21.10' E.P.
 (3) South 30.82' Fence post
 (4) N 45° W 18.30' Cconc. headwall

1972 Survey by J. Snyder, L. 1406, Pg. 24-27. Found 1/2" pipe, reset 3/4" x 18" pipe.
 (5) North 33.0' R/W pipe
 (6) N 15° W 31.3' 30" Willow
 (7) N 70° W 61.3' 25" Cottonwood
 (8) N 45° W 67.6' 6" Scotch pine

1984 Survey by John Blanchard, Job #84-150, Noted F.I. at corner.
 Meas. North to found Mon. 1331.69'
 Record 1331.90'
 Meas. West to 1/16 Mon. 1342.69'
 Record 1341.90'

SECTION 'B' CONTINUED

Removed stone and found rotted wood below. I believe this stone rests on the G.L.O. post. I replaced the stone in a vertical position matching our witnesses. Backfilled the hole. Set a 1" x 18" iron pipe and standard remon. cap stamped 37277 on top of stone.

We tied the corner monument to found irons in Milan Acres Subd. and found it to fit within 0.14' E-W over all plat distance and 0.05' N-S with existing R/W irons. For sections 25, 26, 35 and 36, Aug. G.L.O. chain is 66.41'.

From M-13 to L-13 we measured 2656.10 + 40 = G.L.O. 66.40'
 Measured West to 1/16 corner 1342.65', record 1341.96'
 Measured West to S 1/4 corner 2656.10', record 2655.96'.

SECTION 'C' CONTINUED

(9) North 21.29' Utility pole. Found P.K. in east face set RT, PK.
 (10) N 80° E 38.5' Sign post, "Pass with Care"
 (11) S 65° W 47.46' East end C.M.P.
 (12) N 75° W 114.10' Utility pole, set RT, PK in east face
 (13) South 2.5' Traveled centerline of road.

APPROVED

DATE 4/5/94

CO. REP. [Signature]