


**SURVEY & REMONUMENTATION**


MAY 08 2000

**SECTION**

**LAND CORNER RECORDATION CERTIFICATE**  
Filing Requirement of Act 74, Mich. P.A. 1970

For corners in

<u>WASHTENAW</u> (County)	Located In:	Corner Code #
1. Public Land Survey AUGUSTA TWP	T <u>4S</u> R <u>7E</u>	<u>E-7</u>
2. Property controlling in Section	T _____ R _____ T _____ R _____ T _____ R _____	 5094695 Page: 1 of 2 02/07/2000 02:55P CORREM L-2 P-264
3. Miscellaneous Property in Sec.	S _____ T _____ R _____ S _____ T _____ R _____ S _____ T _____ R _____	
4. Lot No. _____, Recorded Plat _____	Peggy M. Haines - Washtenaw Co. Register of Deeds Stamp & File Number	
5. Private Claims _____		

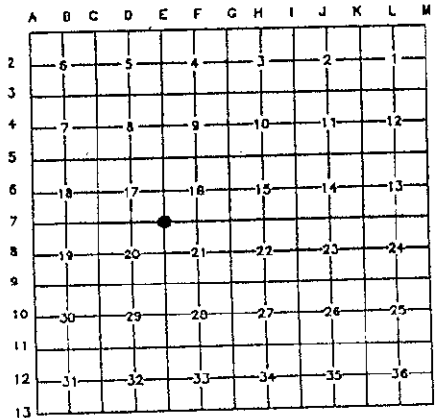

I, LORI E. BEYER, in a field survey on OCTOBER 02, 19 99, do hereby certify that under requirements of P.A. 74, Michigan P.A. of 1970, the corner points mentioned in lines 1 and 2 above were in conformance with regulations and rules therefore as required in the current manual of survey instructions of the United States Department of the Interior, Bureau of Land Management or by decree of a Court of Law and/or that the corner points mentioned in lines 3,4 and 5 above were in conformance with the rules of the Michigan Board of Land Surveyors or by Decree of a Court of Law; established, re-established, monumented, re-monumented, recovered, found as expressed below:

**1999 REMONUMENTATION CORNER**

A. Description of original monument and accessories and/or subsequent restoration:  
G.L.O. - JOSEPH FRANCIS - 1819  
SET POST IN SWAMPY LAND WITH ASH AND ELM  
NO BEARING TREES LISTED

Continued on Back

B. Description of corner evidence and/or method applied in restoring or reestablishing corner:  
FOUND 1/2" IRON PIPE WITH ILLEGIBLE YELLOW CAP 3" BELOW GRAVEL. DUG AND FOUND RR SPIKE 6" BELOW GRAVEL LYING ON ITS SIDE. FOUND OLD 1/2" IRON PIPE 10" DOWN ALONGSIDE UPPER PIPE. REMOVED UPPER PIPE (LEANING SLIGHTLY). DUG TO 22" INTO SAND. 1/2" PIPE STILL SOLIDLY DRIVEN. AT A LATER DATE FOUND 1 1/4" IRON PIPE 1.13' EAST AND 0.20' NORTH OF 1/2" IRON. 1/2" IRON PIPE BELIEVED TO BE CORRECT PER PEER REVIEW COMMITTEE. DROVE 3/4" x 18" IRON PIPE OVER 1/2" IRON PIPE AND SET ALUMINUM REMON. CAP STAMPED '41092' ON 3/4" IRON PIPE. DROVE 1 1/4" IRON PIPE DOWN TO 1' BELOW GRAVEL AND LEFT IN PLACE.

C. Description of monument for corner and accessories established to perpetuate locating the position of the corner:  
3/4" x 18" IRON PIPE OVER 1/2" IRON WITH ALUMINUM REMON. CAP STAMPED '41092'  
6" BELOW GRAVEL ROAD AND 9' NORTH OF CENTERLINE OF TALLADAY RD. AND IN CENTERLINE OF HITCHINGHAM RD.

- |                        |         |        |                          |
|------------------------|---------|--------|--------------------------|
| (2) 36" DYING MAPLE    | S 70° W | 86.7'  | TO CENTER NORTH SIDE     |
| (3) SW COR. BRIDGE     | N 22° W | 16.8'  |                          |
| (4) SE COR. BRIDGE     | N 45° E | 21.0'  |                          |
| (9) SW GUARDRAIL POST  | N 40° W | 14.78' | SET NAIL/TAG TOP OF POST |
| (10) SE GUARDRAIL POST | N 53° E | 20.00' | SET NAIL/TAG TOP OF POST |
| (7) GUY POLE           | S 60° W | 72.93' | SET NAIL/TAG NORTH SIDE  |
| (5) U. POLE            | N 67° E | 61.88' | SET NAIL/TAG WEST SIDE   |
| (6) U. POLE            | S 18° E | 50.12' | SET NAIL/TAG WEST SIDE   |
| (8) 12" ASH            | S 20° E | 67.9'  | TO CTR OF EAST SIDE      |



AFTER CAREFUL EXAMINATION OF RECORD DOCUMENTATION AND FIELD OBSERVATIONS, I BELIEVE THIS POINT SHOULD BE ACCEPTED AS THE BEST AVAILABLE EVIDENCE OF THE POSITION OF THE ORIGINAL CORNER.  
THIS CORNER WAS RATIFIED BY THE PEER REVIEW COMMITTEE ON DECEMBER 13, 1999.

Signed by Lori E. Beyer  
Surveyor's Michigan License No. 41092

Date Dec 13, 1999

APPROVED  
DATE 11/22/99  
CO. REP. KX



5094695  
 Page: 2 of 2  
 02/07/2000 02:55P  
 L-2 P-265

E-7 CONTINUED FROM PARAGRAPH A

Peggy M. Haines - Washtenaw Co. CORREM

*Copy-*

WASHTENAW COUNTY GRID BOOK - SURVEYOR UNKNOWN - DATE UNKNOWN

STONE WITH SQUARE TOP

1) 16" MAPLE	S 45° W	53.75'
2) 18" MAPLE	S 71° W	86.75'
3) SW COR BRIDGE	N 29° W	16.80'
4) SE COR BRIDGE	N 49° E	19.80'

L.C.R.C. LIBER 2 PAGE 301 - HOWARD W. TAFT #12032 - AUGUST 1972  
 P.A. 132 CERTIFICATE OF SURVEY - LIBER 1413 PAGE 971 - 1972 - SAME WITNESSES  
 P.A. 132 CERTIFICATE OF SURVEY - LIBER 1423 PAGE 226 - 1972 - SAME WITNESSES

FOUND 1/2" IRON PIPE

1) 30" S. MAPLE	S 45° W	53.7'
2) 40" S. MAPLE	S 71° W	86.7'
3) SW COR BRIDGE	N 29° W	16.8'
4) SE COR BRIDGE	N 49° E	19.8'

P.A. 132 CERTIFICATE OF SURVEY - UNRECORDED - 1978 - R. TIMOTHY TIETSEMA #20712  
 (MONUMENT NOT DESCRIBED)

1) 24" S. MAPLE	S 45° W	53.75'
3) SW COR BRIDGE	N 29° W	16.8'
4) SE COR BRIDGE	N 49° E	19.8'

WASHTENAW COUNTY ROAD COMMISSION FIELD BOOK - KEVIN ANDERSON P.S. - OCTOBER 1995

FOUND 1/2" IRON PIPE

2) 36" S. MAPLE	S 73° W	86.8'	
3) SW COR BRIDGE	N 30° W	16.7'	
4) SE COR BRIDGE	N 49° E	19.8'	
5) U. POLE	N 63° E	61.73'	FD PK
6) P. POLE	S 20° E	50.14'	FD PK
7) U. POLE	S 63° W	73.00'	SET PK
8) 12" ASH	S 42° E	87.0'	TO CTR
9) GUARD POST	N 40° W	14.73'	FD PK
10) GUARD POST	N 54° E	20.01'	FD PK

SURVEY &  
 REMONUMENTATION

MAY 08 2000

SECTION