


MAY 03 2000


SECTION

LAND CORNER RECORDATION CERTIFICATE
Filing Requirement of Act 74, Mich. P.A. 1970

For corners in

<u>WASHTENAW</u> (County)	Located In:	Corner Code #	
1. Public Land Survey AUGUSTA TWP	T <u>4S</u> R <u>7E</u>	<u>E-11</u>	 <p>5094699 Page: 1 of 2 02/07/2000 02:55P L-2 P-272</p>
2. Property controlling in Section	S _____ T _____ R _____	-	
3. Miscellaneous Property in Sec.	S _____ T _____ R _____	-	
4. Lot No. _____, Recorded Plat _____	S _____ T _____ R _____	-	
5. Private Claims _____	S _____ T _____ R _____	-	

Peggy M. Haines - Washtenaw Co. CORREN
Register of Deeds Stamp & File Number

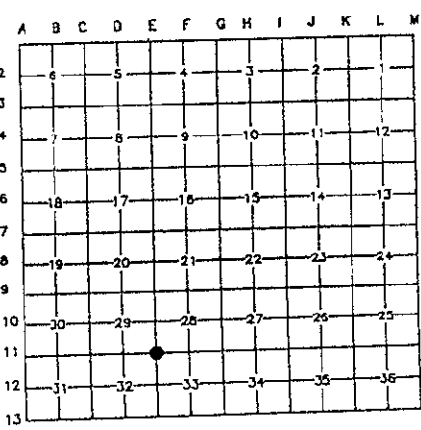

I, LORI E. BEYER, in a field survey on OCTOBER 02, 19 99, do hereby certify that under requirements of P.A. 74, Michigan P.A. of 1970, the corner points mentioned in lines 1 and 2 above were in conformance with regulations and rules therefore as required in the current manual of survey instructions of the United States Department of the Interior, Bureau of Land Management or by decree of a Court of Law and/or that the corner points mentioned in lines 3,4 and 5 above were in conformance with the rules of the Michigan Board of Land Surveyors or by Decree of a Court of Law; established, re-established, monumented, re-monumented, recovered, found as expressed below:


1999 REMONUMENTATION CORNER

- A. Description of original monument and accessories and/or subsequent restoration:
G.L.O. - JOSEPH FRANCIS - 1819
SET POST
NO BEARING TREES

Continued on Back

- B. Description of corner evidence and/or method applied in restoring or reestablishing corner:
FOUND 1/2" PINCH TOP IRON PIPE 3" BELOW GRAVEL. REMOVED AND DUG 14" INCHES AND FOUND 1 1/4" IRON PIPE SURROUNDED BY BRICK AND CLAY TILE. DROVE 1/2" x 8" IRON PIPE INTO 1 1/4" IRON PIPE WITH ALUMINUM REMON. CAP STAMPED "41092" 6" BELOW GRAVEL.
- C. Description of monument for corner and accessories established to perpetuate locating the position of the corner:
1/2" IRON PIPE WITH ALUMINUM REMON. CAP STAMPED #41092 DRIVEN INTO 1 1/2" IRON PIPE 6" BELOW GRAVEL. CORNER IS 5' WEST OF THE CL OF HITCHINGHAM ROAD.

5) U. POLE	N 42° W	49.75'	SET NAIL/TAG EAST SIDE
7) GUY POLE	N 63° E	59.84'	SET NAIL/TAG SOUTHEAST SIDE
2) 70" TW. COTTONWOOD	S 88° E	156.17'	SET NAIL/TAG SOUTH SIDE
8) 26" TW. CHINESE ELM	S 43° E	58.30'	SET NAIL/TAG WEST SIDE
9) P. POLE	S 15° W	207.69'	SET NAIL/TAG WEST SIDE

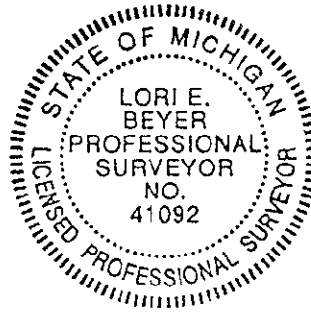

AFTER CAREFUL EXAMINATION OF RECORD DOCUMENTATION AND FIELD OBSERVATIONS, I BELIEVE THIS POINT SHOULD BE ACCEPTED AS THE BEST AVAILABLE EVIDENCE OF THE POSITION OF THE ORIGINAL CORNER.
THIS CORNER WAS RATIFIED BY THE PEER REVIEW COMMITTEE ON NOVEMBER 22, 1999.

Signed by Lori E. Beyer
Surveyor's Michigan License No. 41092

Date DEC 03, 1999

APPROVED
DATE 11/22/99
CO. REF. 14

E-11 CONTINUED FROM PARAGRAPH A

WASHTENAW COUNTY ROAD COMMISSION GRID BOOK - K. BARKER - 1930
FOUND A PIECE OF IRON WITH BRICK AROUND IT. RESET WITH IRON BAR SET IN
THE CENTER OF A 6" DRAIN TILE.

1) 16" ELM	N 34° E	46.25'
2) TWIN POPLAR	N 85° E	156.6'

L.C.R.C. LIBER 2 PAGE 89 - GLENN RICHARD #13040 - MAY 1972

FOUND PINCH TOP IRON PIPE		
3) T. POLE	S 70° W	101.95' NAIL & WASHER
4) T. POLE	S 60° E	67.60' NAIL & WASHER
5) E. POLE	N 50° W	49.50' NAIL & WASHER
6) BRACE POLE	N 60° E	61.17' SPIKE

P.A. 132 - CERTIFICATE OF SURVEY - LIBER 1440 PAGE 796 - KENNETH SUYDAM #17635 - JANUARY 1973

FOUND IRON PIPE		
3) T. POLE	S 70° W	101.95'
4) T. POLE	S 60° E	67.60'
5) E. POLE	N 50° W	49.50'
6) BRACE POLE	N 60° E	61.17'

L.C.R.C. LIBER 4 PAGE 382 - ROBERT CAMPBELL, JR. #13028 - OCTOBER 1977

FOUND PINCH TOP IRON PIPE		
2) 55" COTTONWOOD	N 86° E	156.60' NAIL SOUTH SIDE
7) GUY POLE	N 68° E	59.87' NAIL SE SIDE
5) E. POLE	N 50° W	49.50' FD NAIL & WASHER
8) 6" ELM	S 45° E	59.18' NAIL NE SIDE

WASHTENAW COUNTY ROAD COMMISSION - FIELD BOOK - ROBERT CAMPBELL, JR. #13028 - MARCH 1982
FOUND PINCH TOP IRON PIPE - SAME WITNESSES AS LIBER 4 PAGE 382

P.A. 132 - CERTIFICATE OF SURVEY - UNRECORDED - C. WILSON & ASSOCIATES - MAY 1986
P.A. 132 - CERTIFICATE OF SURVEY - UNRECORDED - C. WILSON & ASSOCIATES - JULY 1987 - SAME WITNESSES

FOUND PINCH TOP IRON PIPE		
5) EDISON POLE	N 50° W	49.50'
2) 55" COTTONWOOD	N 86° E	156.60'
7) GUY POLE	N 68° E	59.87'
8) 14" ELM	S 45° E	59.18'



5094699

Page: 2 of 2

02/07/2000 02:55P

Peggy M. Haines - Washtenaw Co. CORREM L-2 P-273

- Copy -

SURVEY &
REPRESENTATION

MAY 5 2000

SECTION