

MAY 2000

SECTION

LAND CORNER RECORDATION CERTIFICATE  
Filing Requirement of Act 74, Mich. P.A. 1970

For corners in

WASHTENAW  
(County)

Located In:

Corner Code #

1. Public Land Survey  
AUGUSTA TWP

T 4S R 7E  
T \_\_\_\_\_ R \_\_\_\_\_  
T \_\_\_\_\_ R \_\_\_\_\_  
T \_\_\_\_\_ R \_\_\_\_\_



5094707  
Page: 1 of 2  
02/07/2000 02:55P  
L-2 P-288


2. Property controlling  
in Section

S \_\_\_\_\_ T \_\_\_\_\_ R \_\_\_\_\_  
S \_\_\_\_\_ T \_\_\_\_\_ R \_\_\_\_\_  
S \_\_\_\_\_ T \_\_\_\_\_ R \_\_\_\_\_  
S \_\_\_\_\_ T \_\_\_\_\_ R \_\_\_\_\_

Peggy M. Haines - Washtenaw Co. CORREM  
Copy

Register of Deeds Stamp & File Number

4. Lot No. \_\_\_\_\_, Recorded Plat \_\_\_\_\_  
5. Private Claims \_\_\_\_\_

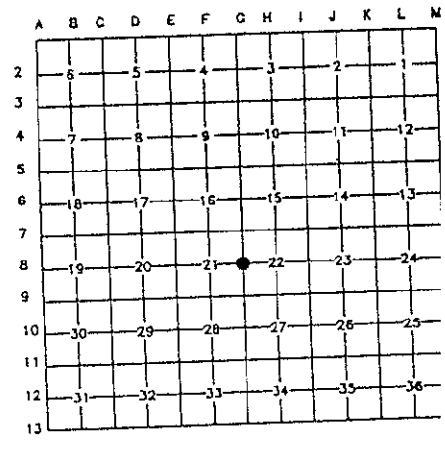

I, LORI E. BEYER, in a field survey on OCTOBER 31, 19 99, do hereby certify that under requirements of P.A. 74, Michigan P.A. of 1970, the corner points mentioned in lines 1 and 2 above were in conformance with regulations and rules therefore as required in the current manual of survey instructions of the United States Department of the Interior, Bureau of Land Management or by decree of a Court of Law and/or that the corner points mentioned in lines 3,4 and 5 above were in conformance with the rules of the Michigan Board of Land Surveyors or by Decree of a Court of Law; established, re-established, monumented, re-monumented, recovered, found as expressed below:

1999 REMONUMENTATION CORNER

A. Description of original monument and accessories and/or subsequent restoration:

G.L.O. - JOSEPH FRANCIS - 1819  
SET POST  
6" IRONWOOD N 65° E 16 LINKS  
5" BEECH N 88° W 18 LINKS

Continued on Back

B. Description of corner evidence and/or method applied in restoring or reestablishing corner:

FOUND 5/8" IRON PIPE 1.1 FT. WEST OF WEST EDGE OF PAVEMENT OF WHITTAKER ROAD 1.5 FT BELOW GRAVEL SHOULDER  
PLACED ALUMINUM REMON. CAP ON 5/8" IRON PIPE

C. Description of monument for corner and accessories established to perpetuate locating the position of the corner:

5/8" IRON PIPE WITH ALUMINUM REMON. CAP STAMPED '41092'  
1.1 FT. WEST OF THE WEST EDGE OF PAVEMENT OF WHITTAKER ROAD.

- |                             |         |        |                         |
|-----------------------------|---------|--------|-------------------------|
| 5) POWER POLE               | S 82° E | 76.20' | SET NAIL/TAG SOUTH SIDE |
| 4) 12" CMP CULVERT          | N 20° W | 28.30' | CUT 'V' IN SOUTH END    |
| 6) NE COR N'LY BRICK PILLAR | N 12° W | 71.23' |                         |
| 7) FIRE HYDRANT             | S 35° W | 48.67' | TOP NUT                 |
| 8) 15" QUAD COTTONWOOD      | S 50° E | 94.24' | SET NAIL/TAG WEST SIDE  |



AFTER CAREFUL EXAMINATION OF RECORD DOCUMENTATION AND FIELD OBSERVATIONS, I BELIEVE THIS POINT SHOULD BE ACCEPTED AS THE BEST AVAILABLE EVIDENCE OF THE POSITION OF THE ORIGINAL CORNER.  
THIS CORNER WAS RATIFIED BY THE PEER REVIEW COMMITTEE ON NOVEMBER 22, 1999.

Signed by Lori E. Beyer  
Surveyor's Michigan License No. 41092

Date DEC 03, 1999

APPROVED  
DATE 11/22/1  
CO. REP. Kx



5094707  
 Page: 2 of 2  
 02/07/2000 02:55P

G-8 CONTINUED FROM PARAGRAPH A

Peggy M. Haines - Washtenaw Co. CORREM L-2 P-289

S. PETTIBONE - YEAR UNKNOWN

*- Copy -*

- |              |         |       |
|--------------|---------|-------|
| A) 15" BEECH | N 69° W | 20.5' |
| B) 20" BEECH | N 80° E | 17.8' |

WASHTENAW COUNTY GRID BOOK - NO WITNESSES POSTED - NO ARMSTRONG WITNESSES FOUND.

L.C.R.C. LIBER 3 PAGE 499 - WERNER SOMMER #12030 - MARCH 1974

FOUND 5/8" IRON 2.8' WEST OF PAVEMENT

- |                 |         |        |                     |
|-----------------|---------|--------|---------------------|
| 1) 20" SYCAMORE | WEST    | 9.30'  | NAIL & DISC N. SIDE |
| 2) TEL. POLE    | EAST    | 60.48' | NAIL & DISC S. SIDE |
| 3) ROAD SIGN    | N 50° E | 39.31' |                     |
| 4) 12" CMP      | N 20° W | 28.30' | 'V' IN S. END       |

L.C.R.C. LIBER 7 PAGE 215 - DENNIS GRIGGS #23511 - APRIL 1988

FOUND 5/8" IRON 1.1' WEST OF WEST PAVEMENT

- |               |         |        |                 |
|---------------|---------|--------|-----------------|
| 1) SYCAMORE   | WEST    | 9.30'  | NAIL N. SIDE    |
| 5) POWER POLE | EAST    | 76.1'  | NAIL IN N. SIDE |
| 4) 12" CMP    | N 20° W | 28.30' | 'V' IN S. END   |

WASHTENAW COUNTY ROAD COMMISSION - FIELD BOOK - KEVIN ANDERSON P.S. - 1995(?)

FOUND 1/2" IRON 1.5' BELOW GRAVEL SHOULDER

- |                 |         |        |                  |
|-----------------|---------|--------|------------------|
| 1) 26" SYCAMORE | WEST    | 9.10'  |                  |
| 5) POWER POLE   | EAST    | 76.12' | FD NAIL          |
| 6) 9" TWIN ELM  | S 36° W | 24.04' | SET NAIL E. SIDE |
| 4) 12" CMP      | N 20° W | 28.30' | 'V' IN S. END    |

SEARCHED &  
 REM

MAY 10 2000

SECTION