

RECEIVED  
SECTION

JAN 20 2000

LAND CORNER RECORDATION CERTIFICATE  
Filing Requirement of Act 74, Mich. P.A. 1970

SECTION

For corners in

WASHTENAW  
(County)

Located In: T 4S R 7E Corner Code # G-10


1. Public Land Survey AUGUSTA TWP  
T \_\_\_\_\_ R \_\_\_\_\_  
T \_\_\_\_\_ R \_\_\_\_\_  
T \_\_\_\_\_ R \_\_\_\_\_

2. Property controlling in Section S \_\_\_\_\_ T \_\_\_\_\_ R \_\_\_\_\_  
S \_\_\_\_\_ T \_\_\_\_\_ R \_\_\_\_\_

3. Miscellaneous Property in Sec. S \_\_\_\_\_ T \_\_\_\_\_ R \_\_\_\_\_  
S \_\_\_\_\_ T \_\_\_\_\_ R \_\_\_\_\_


4. Lot No. \_\_\_\_\_, Recorded Plat \_\_\_\_\_

5. Private Claims \_\_\_\_\_

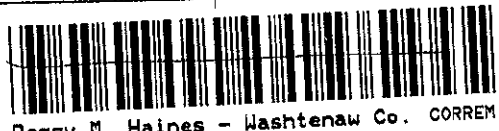

5094709  
Page: 1 of 2  
02/07/2000 02:55P  
L-2 P-292

Peggy M. Haines - Washtenaw Co. CORREM  
- Copy - Register of Deeds Stamp & File Number

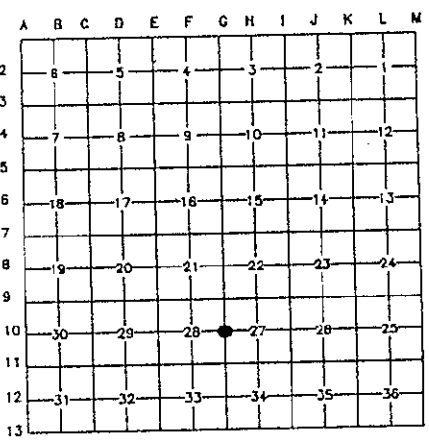

I, LORI E. BEYER, in a field survey on NOVEMBER 20, 19 99, do hereby certify that under requirements of P.A. 74, Michigan P.A. of 1970, the corner points mentioned in lines 1 and 2 above were in conformance with regulations and rules therefore as required in the current manual of survey instructions of the United States Department of the Interior, Bureau of Land Management or by decree of a Court of Law and/or that the corner points mentioned in lines 3, 4 and 5 above were in conformance with the rules of the Michigan Board of Land Surveyors or by Decree of a Court of Law; established, re-established, monumented, re-monumented, recovered, found as expressed below:

1999 REMONUMENTATION CORNER

A. Description of original monument and accessories and/or subsequent restoration:

G.L.O. -- JOSEPH FRANCIS -- 1819  
SET POST  
7" IRONWOOD N 61° W 12 LINKS  
15" OAK S 61° E 31 LINKS

Continued on Back

B. Description of corner evidence and/or method applied in restoring or reestablishing corner:

FOUND 3/4" IRON PIPE WITH WCRC CAP #13028 AT ROAD SURFACE OF WHITTAKER ROAD.  
CHECKED WITNESSES. RESET WITH 3/4" x 24" IRON PIPE WITH ALUMINUM REMON. CAP  
STAMPED '41092' IN MONUMENT BOX.

C. Description of monument for corner and accessories established to perpetuate locating the position of the corner:

3/4" x 24" IRON PIPE WITH ALUMINUM REMON. CAP STAMPED '41092' IN MONUMENT BOX.

- |                        |         |         |                         |
|------------------------|---------|---------|-------------------------|
| 6) 50" MAPLE           | N 50° E | 32.75'  | SET NAIL/TAG NW SIDE    |
| 2) 29" MAPLE           | S 20° E | 59.95'  | SET NAIL/TAG WEST SIDE  |
| 7) 29" MAPLE           | S 12° E | 86.75'  | SET NAIL/TAG WEST SIDE  |
| 10) E. EDGE OF PAVMENT | EAST    | 11.7'   |                         |
| 11) W. EDGE OF PAVMENT | WEST    | 12.4'   |                         |
| 12) 1/2" IRON PIPE     | EAST    | 33.14'  | CAP #27446              |
| 8) UTILITY POLE        | S 13° W | 121.93' | SET NAIL/TAG NW SIDE    |
| 13) UTILITY POLE       | WEST    | 32.30'  | SET NAIL/TAG NORTH SIDE |
| 14) FIRE HYDRANT       | N 07° W | 88.73'  | TOP NUT                 |



AFTER CAREFUL EXAMINATION OF RECORD DOCUMENTATION AND FIELD OBSERVATIONS, I BELIEVE THIS POINT SHOULD BE ACCEPTED AS THE BEST AVAILABLE EVIDENCE OF THE POSITION OF THE ORIGINAL CORNER.  
THIS CORNER WAS RATIFIED BY THE PEER REVIEW COMMITTEE ON NOVEMBER 22, 1999.

Signed by Lori E. Beyer  
Surveyor's Michigan License No. 41092

Date DEC 03, 1999

APPROVED  
DATE 12/20/99  
CO. REP. EA

APR 2000

## SECTION

5094709  
Page: 2 of 2  
02/07/2000 02:55P

G-10 CONTINUED FROM PARAGRAPH A

Peggy M. Haines - Washtenaw Co. CORREM L-2 P-293

WASHTENAW COUNTY GRID BOOK - NO WITNESSES POSTED - NO ARMSTRONG WITNESSES FOUND.

P.A. 132 CERTIFICATE OF SURVEY - LIBER 1371 PAGE 879 - JOHN SNDR - SEPTEMBER 1971

FOUND IRON PIPE

1) 14" SYCAMORE	S 45° W	38.1'
2) 14" MAPLE	S 30° E	60.2'
3) 24" MAPLE	N 70° E	22.8'
4) 12" ELM	N 40° E	54.7'

L.C.R.C. LIBER 2 PAGE 67 - GLENN RICHARD #13040 - MAY 1972

P.A. 132 CERTIFICATE OF SURVEY - LIBER 1406 PAGES 139-141 - 1972 - SAME WITNESSES

FOUND 1" IRON IN PAVEMENT

1) 30" SYCAMORE	S 35° W	37.24'
5) NAIL IN E.P.	S 15° W	123.15'
2) 30" MAPLE	S 30° E	59.94'
6) 48" MAPLE	N 50° E	33.00'




L.C.R.C. LIBER 3 PAGE 187 - JOHN OLIVER # 19840 - AUGUST 1973

FOUND 3/4" IRON PIPE

1) 27" SYCAMORE	S 30° W	37.25'
6) 42" MAPLE	N 50° E	33.00'
2) 27" MAPLE	S 35° E	59.95'
7) 27" MAPLE	S 25° E	87.50'

P.A. 132 CERTIFICATE OF SURVEY - UNRECORDED - ROSKELLY, JEKABSON &amp; ASSOC. - OCTOBER 1980

FOUND 1" IRON PIPE

1) 27" SYCAMORE	S 35° W	37.24'	NAIL
6) 48" MAPLE	N 50° E	33.00'	NAIL
2) 30" MAPLE	S 35° E	59.95'	NAIL
8) D.E. POLE	S 15° W	121.71'	NAIL
9) D.E. POLE	N 85° W	32.29'	NAIL

L.C.R.C. LIBER 7 PAGE 70 - ROBERT CAMPBELL JR #13028 - JUNE 1984

FOUND 3/4" IRON PIPE AT ROAD SURFACE. RESET WITH 3/4" x 18" IRON PIPE AT SURFACE AFTER RECONSTRUCTION OF WHITTAKER ROAD

1) 30" SYCAMORE	S 30° W	38.11'	SET NAIL E. SIDE
6) 42" MAPLE	N 50° E	33.00'	
2) 26" MAPLE	S 35° E	59.95'	
7) 27" MAPLE	S 25° E	87.50'	
10) E. EDGE OF PAVMENT	EAST	11.7'	
11) W. EDGE OF PAVEMENT	WEST	12.4'	

P.A. 132 CERTIFICATE OF SURVEY - UNRECORDED - C. WILSON &amp; ASSOC. - MAY 1986

FOUND 3/4" IRON PIPE

1) 30" SYCAMORE	S 35° W	37.24'
6) 48" MAPLE	N 50° E	33.00'
2) 26" MAPLE	S 35° E	59.95'
5) EDISON POLE	S 15° W	123.15'
7) 27" MAPLE	S 25° E	87.50'

P.A. 132 CERTIFICATE OF SURVEY - LIBER 2593 PAGE 515 - JOHN BLANCHARD #27446 - FEBRUARY 1989  
NO MONUMENT OR WITNESSES DESCRIBED