

REM

2000

SECTION


LAND CORNER RECORDATION CERTIFICATE
Filing Requirement of Act 74, Mich. P.A. 1970

For corners in

Form with fields for WASHTENAW (County), Located In: T 4S R 7E, Corner Code # H-9, and numbered items 1-5 describing the survey and property.

Barcode area containing registration information: 5094714, Page: 1 of 2, 02/07/2000 02:55P, Peggy M. Haines - Washtenaw Co. CORREM L-2 P-302, register of Deeds Stamp & File Number

Copy -

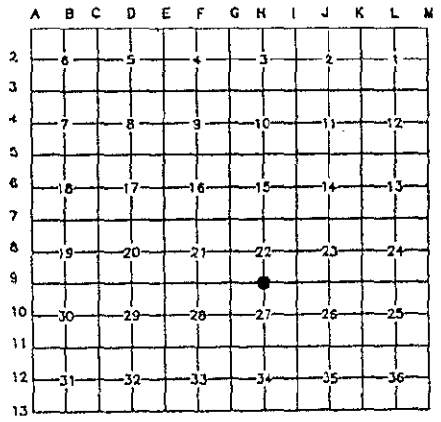

I, LORI E. BEYER, in a field survey on OCTOBER 31, 19 99, do hereby certify that under requirements of P.A. 74, Michigan P.A. of 1970, the corner points mentioned in lines 1 and 2 above were in conformance with regulations and rules therefore as required in the current manual of survey instructions of the United States Department of the Interior, Bureau of Land Management or by decree of a Court of Law and/or that the corner points mentioned in lines 3, 4 and 5 above were in conformance with the rules of the Michigan Board of Land Surveyors or by Decree of a Court of Law; established, re-established, monumented, re-monumented, recovered, found as expressed below:

1999 REMONUMENTATION CORNER

- A. Description of original monument and accessories and/or subsequent restoration: G.L.O. - JOSEPH FRANCIS - 1819 SET POST 10" ASH S 17° W 18 LINKS

Continued on Back

- B. Description of corner evidence and/or method applied in restoring or reestablishing corner: FOUND 5/8" IRON ROD 1" BELOW PAVEMENT SURFACE 1 FT. SOUTH OF CENTERLINE OF WILLOW ROAD. CHECKED WITNESSES. RESET WITH 3/4" x 24" IRON PIPE IN MONUMENT BOX. PLACED ALUMINUM REMON. CAP STAMPED #41092 ON 3/4" IRON PIPE.
C. Description of monument for corner and accessories established to perpetuate locating the position of the corner: 3/4" x 18" IRON PIPE WITH ALUMINUM REMON. IN MONUMENT BOX 1 FT. SOUTH OF CENTERLINE OF WILLOW ROAD.

Table with 4 columns: Monument Description, Direction, Distance, and Action. Includes items like UTILITY POLE, MAPLE, MAPLE STUMP, FIRE HYDRANT, SPRUCE, and MAPLE.



AFTER CAREFUL EXAMINATION OF RECORD DOCUMENTATION AND FIELD OBSERVATIONS, I BELIEVE THIS POINT SHOULD BE ACCEPTED AS THE BEST AVAILABLE EVIDENCE OF THE POSITION OF THE ORIGINAL CORNER.

THIS CORNER WAS RATIFIED BY THE PEER REVIEW COMMITTEE ON NOVEMBER 22, 1999.

APPROVED DATE 11/22/99 CO. REP. [Signature]

Signed by Lori E. Beyer Surveyor's Michigan License No. 41092

Date Dec 03, 1999

H-9 CONTINUED FROM PARAGRAPH A

WASHTENAW COUNTY GRID BOOK - K. BARKER - JULY 1930

FOUND POINTED STONE. RESET WITH A 1"x2B" IRON PIPE, STONES, BRICK, AND TILE

1) 24" MAPLE	S 76° W	86.8'
2) 16" WALNUT	N 61° W	54.35'
3) SE COR HOUSE	N 20° W	91.0'
4) 20" MAPLE	N 11° E	39.6'
5) 6" MAPLE	N 53° W	80.75'
6) 34" MAPLE	S 59° W	42.2'

L.C.R.C. LIBER 1 PAGE 583 - KENNETH SUYDAM #17636 - SEPTEMBER 1971

FOUND IRON IN PAVMENT

4) 36" SOFT MAPLE	NORTH	37.85'
6) 42" SOFT MAPLE	S.W.	40.5'

L.C.R.C. LIBER 2 PAGE 99 - GLENN RICHARD #13040 - JULY 1972

BOAT SPIKE IN PAVEMENT

2) 20" WALNUT	N 45° W	54.08'
7) TELEPHONE POLE	N 10° E	29.75'
8) 30" MAPLE	S 10° E	32.91'
6) 40" MAPLE	S 60° W	40.51'

P.A. 132 CERTIFICATE OF SURVEY - LIBER 02551 PAGE 827 - JOHN BLANCHARD #27446 - JUNE 1991

P.A. 132 CERTIFICATE OF SURVEY - LIBER 02825 PAGE 821 - JOHN BLANCHARD #27446 - APRIL 1989  
(MONUMENT NOT DESCRIBED - NO WITNESSES POSTED)



5094714

Page: 2 of 2  
02/07/2000 02:55P

Peggy M. Haines - Washtenaw Co. CORREM L-2 P-303

-Copy-

351  
SECTION

APR 10 2000

SECTION