
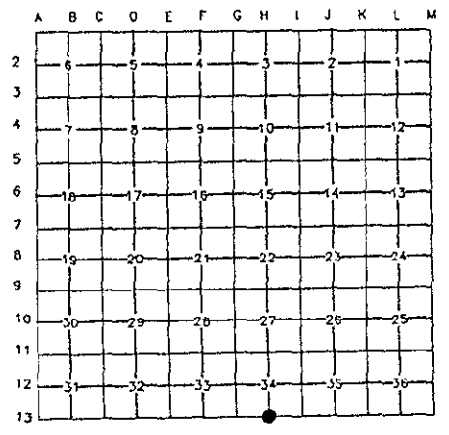


RECORDED
 SECTION
 MAY 10 2000

SECTION LAND CORNER RECORDATION CERTIFICATE
 Filing Requirement of Act 74, Mich. P.A. 1970

For corners in

<u>WASHTENAW</u> (County)	Located In:	Corner Code #
1. Public Land Survey AUGUSTA TWP	T <u>4S</u> R <u>7E</u>	<u>H-13</u>
2. Property controlling in Section	T _____ R _____ S _____ T _____ R _____	 5094716 Page: 1 of 2 02/07/2000 02:55P Peggy M. Haines - Washtenaw Co. CORREM L-2 P-306 <i>copy</i> Register of Deeds Stamp & File Number
3. Miscellaneous Property in Sec.	S _____ T _____ R _____ S _____ T _____ R _____	
4. Lot No. _____, Recorded Plat _____		
5. Private Claims _____		



I, LORI E. BEYER, in a field survey on OCTOBER 03, 19 99, do hereby certify that under requirements of P.A. 74, Michigan P.A. of 1970, the corner points mentioned in lines 1 and 2 above were in conformance with regulations and rules therefore as required in the current manual of survey instructions of the United States Department of the Interior, Bureau of Land Management or by decree of a Court of Law and/or that the corner points mentioned in lines 3,4 and 5 above were in conformance with the rules of the Michigan Board of Land Surveyors or by Decree of a Court of Law; established, re-established, monumented, re-monumented, recovered, found as expressed below:

1999 REMONUMENTATION CORNER


A. Description of original monument and accessories and/or subsequent restoration:
 G.L.O. - JOSEPH FRANCIS - 1819
 SET POST
 16" RED OAK EAST 31 LINKS
 16" W. OAK N 12" W 42 LINKS

Continued on Back

B. Description of corner evidence and/or method applied in restoring or reestablishing corner:
 FOUND 5/8" IRON BAR WITH ILLEGIBLE CAP INSIDE MONUMENT BOX IN CENTERLINE OF OAKVILLE-WALTZ ROAD. CHECKED WITNESSES.
 PLACED ALUMINUM REMON CAP STAMPED '41092' OVER 5/8" IRON BAR.

C. Description of monument for corner and accessories established to perpetuate locating the position of the corner:
 5/8" IRON BAR WITH ALUMINUM REMON CAP STAMPED '41092' IN MONUMENT BOX IN CENTERLINE OF OAKVILLE WALTZ ROAD

9) POWER POLE	NORTH	44.10'	SET NAIL/TAG WEST SIDE
10) 13" WALNUT	N 29° E	66.01'	SET NAIL/TAG EAST SIDE
11) POWER POLE	S 02° W	28.65'	SET NAIL/TAG EAST SIDE
12) SW COR HSE	N 41° W	167.50'	
8) N 1/4 COR SEC 3, T5S, R7E	WEST	48.32'	

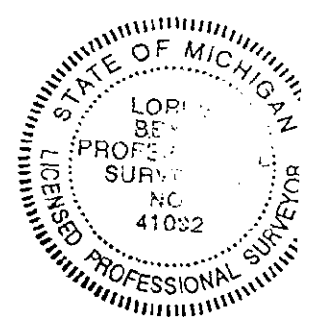

AFTER CAREFUL EXAMINATION OF RECORD DOCUMENTATION AND FIELD OBSERVATIONS, I BELIEVE THIS POINT SHOULD BE ACCEPTED AS THE BEST AVAILABLE EVIDENCE OF THE POSITION OF THE ORIGINAL CORNER.
 THIS CORNER WAS RATIFIED BY THE PEER REVIEW COMMITTEE ON DECEMBER 20, 1999.

Signed by Lori E. Beyer
 Surveyor's Michigan License No. 41092

Date DEC 20, 1999

APPROVED
 DATE 12/20/99
 CO. REP. MB

H-13 CONTINUED FROM PARAGRAPH A

WASHTENAW COUNTY GRID BOOK - W.J. ARMSTRONG - JUNE 1935

FOUND VERY OLD WOOD STAKE. RESET WITH 1 1/2" IRON PIPE AND BROKEN BRICK

1) 8" B. WALNUT	EAST	330.4'
2) 5" B. WALNUT	S 10° E	10.0'
3) 20" HICKORY	N 02° W	93.7'
4) 30" W. OAK	S 70° W	204.0'

L.C.R.C. LIBER 4 PAGE 286 - NORMAN F. FAHRNER # 17620 - JUNE 1977

P.A. 132 CERTIFICATE OF SURVEY - LIBER 1600 PAGE 554 - JUNE 1977 - SAME WITNESSES

P.A. 132 CERTIFICATE OF SURVEY - UNRECORDED - MAY 1981 - SAME WITNESSES

FOUND IRON PIPE

2) 18" B. WALNUT	S 10° E	10.0'
3) 20" HICKORY	N 02° W	93.7'
5) 3" WALNUT	N 30° E	30.1'
6) 2" WALNUT	N 02° W	24.8'

P.A. 132 CERTIFICATE OF SURVEY - LIBER 3294 PAGE 841 - JOHN BLANCHARD #27446 - APRIL 1996

P.A. 132 CERTIFICATE OF SURVEY - LIBER 3383 PAGE 208 - JOHN BLANCHARD #27446 - APRIL 1996

MONUMENT NOT DESCRIBED - NO WITNESSES POSTED

MONROE COUNTY ROAD COMMISSION - SCOTT WARNKE, P.S. - DECEMBER 1999 REPORT

"I EXCAVATED A 2.5' x 2.5' HOLE AT LOCATION OF FOUND R.R. SPIKE. I DO NOT RECALL WHAT I FOUND UNDER THE R.R. SPIKE NOR CAN I FIND THE FIELD NOTES FROM MARCH 1998. M.C.R.C. FOUND AN IRON PIPE IN 1978 AND SET A 1/2" IRON PIPE IN EXISTING PIPE. I HAVE A SET OF OLD FIELD NOTES (DATE AND COMPANY NOT GIVEN) WHICH SET THE R.R. SPIKE USING THE M.C.R.C. WITNESSES (SEE BELOW). I DID SET THE 5/8" IRON REBAR INSIDE A MONUMENT BOX AT LOCATION OF FOUND R.R. SPIKE. THE INFORMATION I HAD IN MARCH OF 1998 ALLOWED ME TO MAKE THE DECISION TO SET THE REBAR AND BOX."

3) 16" STUMP	N 02° W	93.52'	NAIL & SHINER
7) 5" HICKORY	S 10° E	70.52'	PK NAIL WEST SIDE
8) N 1/4 COR SEC 3, T5S, R7E	WEST	48.35'	IRON ROD



5094716

Page: 2 of 2
02/07/2000 02:55P

Peggy M. Haines - Washtenaw Co. CORREM

L-2 P-307

- Copy -

RECEIVED
FEB 10 2000

JAN 20 2000

SECTION