

**SURVEY & REMONUMENTATION**

**COPY**

RECORDED  
WASHTENAW COUNTY, MI

MAY - 1 1995

**LAND CORNER RECORDATION CERTIFICATE**  
Filing Requirement of Act 74, Mich. P.A. 1970

FEB 1 8 58 AM '95

For corners in **COMMISSION**

Washtenaw (County) Located In: Corner Code #

1. Public Land Survey	T	<b>4S</b>	R	<b>7E</b>	<b>K-8</b>
	T		R		
	T		R		
	T		R		
2. Property Controlling in Section	S		T		
	S		T		
3. Miscellaneous Property in Sec	S		T		
	S		T		

4. Lot No. \_\_\_\_\_, Recorded Plat \_\_\_\_\_

5. Private Claims \_\_\_\_\_

PEGGY H. MAINES  
COUNTY CLERK/REGISTER

*COPY -*

LISER

**1 PAGE 387 RM**  
*COPY*

Register of Deeds Stamp & File Number

**Thomas L. Sutherland** in a field survey on **December 12**, 19 **94**, do hereby certify that under requirements of P.A. 74, Michigan P.A. of 1970, the corner points mentioned in lines 1 and 2 above were in conformance with regulations and rules therefore as required in the current manual of survey instructions of the United States Department of the Interior, Bureau of Land Management or by a decree of a Court of Law and/or that the corner points mentioned in lines 3, 4 and 5 above were in conformance with the rules of the Michigan Board of Land Surveyors or by a Decree of a Court of Law; established, re-established, monumented, re-monumented, recovered, found as expressed below:

	A	B	C	D	E	F	G	H	I	J	K	L	M
2	6		5		4		3		2		1		
3													
4	7		8		9		10		11		12		
5													
6	18		17		16		15		14		13		
7													
8	19		20		21		22		23		24		
9													
10	30		29		28		27		26		25		
11													
12	31		32		33		34		35		36		
13													

**NOTE: Not more than 4 corners, all in the same town and range, may be recorded on this certificate.**

A Description of original monument and accessories and/or subsequent restoration:

(W.C.R.C. 1932)  
Found Old Wood Stake.  
Re-set with 2" x 48" Iron Pipe and placed 4 bricks around it.  
Elm 18" N11°E 138.35  
Hickory 24" N53°E 137.4  
Elm 2" N50°E 30.25  
Elm Stump 18" S84°W 34.5  
2 Right-of-Way Pipes

(Atwell-Hicks 1974)  
Iron Pipe  
2" Right-of-Way Pipe EAST 33.0  
10" Pine (N. Side of Drive) S15°W 76.5  
Utility Pole (Spike in N. Side) W'y 58.7  
N.E. Corner Porch Step (House #11520) S35°W 135.1  
E-W Culvert S'y 3.0

(Washtenaw Engineering 1975)  
3/4" Iron Pipe  
24" Stump N11°E 138.35  
12" Stump N50°E 30.25  
3" Spruce S70°E 40.1  
12" Pine S25°W 76.6

B. Description of corner evidence found and/or method applied in restoring or reestablishing corner:

Found 1/2" Iron Pipe 6" below Gravel Surface. Dug down an additional 12" but only found backfill to culvert. Re-set 1" x 24" Iron Pipe with an aluminum Washtenaw County Remonumentation Cap and Re-witnessed.

C. Description of monument for corner and accessories established to perpetuate locating the position of the corner:

1" x 24" Iron Pipe with an Aluminum Washtenaw County Remonumentation Cap  
2" Iron Right-of-Way Pipe (Leaning S'y) EAST 33.03  
24" Pine S20°W 76.50 to Nail W/W.C.R. Tag in E. Side  
Power Pole N85°W 58.60 to Nail W/W.C.R. Tag in N. Side  
E-W Culvert S'y 3.0+  
14" Spruce S70°E 40.10 to Nail W/W.C.R. Tag in S. Side

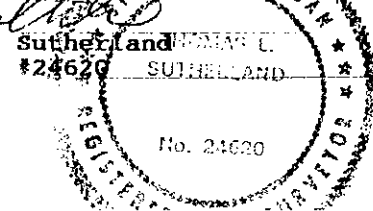
Top/Center 18" C.M.P. S85°W 23.64  
16" Triple Maple N25°E 85.18 to Nail W/W.C.R. Tag in W. Side

**APPROVED**

DATE 12/19/94

CO. REP. KJ

I conclude that after careful study of the record documentation and field observations, that this corner is a careful and faithful perpetuation of the position of the original corner.

Signed by Thomas L. Sutherland  
Surveyor's Michigan License # 24620  


Date December 16, 1994