

**SURVEY &
REMONUMENTATION**

MAY - 1 1995

COMMISSION

For corners in

Washtenaw

(County)

Located In:

Corner Code #

1. Public Land Survey	T	<u>4S</u>	R	<u>7E</u>	<u>K-13</u>
	T		R		
	T		R		
	T		R		
2. Property Controlling in Section	S		T		R
	S		T		R
3. Miscellaneous Property in Sec.	S		T		R
	S		T		R

4. Lot No. _____, Recorded Plat _____
5. Private Claims _____

Thomas L. Sutherland in a field survey on November 15, 19 94, do hereby certify that under requirements of P.A. 74, Michigan P.A. of 1970, the corner points mentioned in lines 1 and 2 above were in conformance with regulations and rules therefore as required in the current manual of survey instructions of the United States Department of the Interior, Bureau of Land Management or by a decree of a Court of Law and/or that the corner points mentioned in lines 3, 4 and 5 above were in conformance with the rules of the Michigan Board of Land Surveyors or by a Decree of a Court of Law; established, re-established, monumented, re-monumented, recovered, found as expressed below:

NOTE: Not more than 4 corners, all in the same town and range, may be recorded on this certificate.

A. Description of original monument and accessories and/or subsequent restoration:

(W.C.R.C. 1935)
Found a large stone.
Re-set with an Iron Pipe and 4 Bricks and set the stone beside the pipe.

10" Twin Walnuts
N3°W 33.6
3" Elm N50°E 7.5

B. Description of corner evidence found and/or method applied in restoring or reestablishing corner:


Found 1 1/2" Iron Pipe & Bricks. Set 1" x 24" Iron Pipe with aluminum Washtenaw County Remonumentation Cap inside existing Iron Pipe.

C. Description of monument for corner and accessories established to perpetuate locating the position of the corner:

1" X 3/4" Iron Pipe with Aluminum Washtenaw County Remonumentation Cap
Twin 20" Walnut N03°W 33.60 to Nail W/W.C.R. Tag in E. Side
E-W Fence SOUTH 0.4
Twin 20" Ash S20°W 45.92 to Nail W/W.C.R. Tag in E. Side
24" Ash S75°W 37.38 to Nail W/W.C.R. Tag in N. Side
18" Elm S60°E 42.13 to Nail W/W.C.R. Tag in S. Side

I conclude that after careful study of the record documentation and field observations, that this corner is a careful and faithful perpetuation of the position of the original corner.

Signed by Thomas L. Sutherland
Surveyor's Michigan License No. 24620

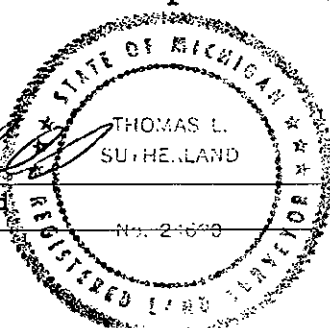

Date December 13, 1994

RECORDED
WASHTENAW COUNTY, MI

COPY

FEB 1 9 00 AM '95

PEGGY H. HAINES
COUNTY CLERK/REGISTER

COPY

LIBER

1 PAGE 392 RM

COPY

Register of Deeds Stamp & File Number

	A	B	C	D	E	F	G	H	I	J	K	L	M
2	6	5	4	3	2	1							
3													
4	7	8	9	10	11	12							
5													
6	18	17	16	15	14	13							
7													
8	19	20	21	22	23	24							
9													
10	30	29	28	27	26	25							
11													
12	31	32	33	34	35	36							
13													

APPROVED

DATE 11/23/94

CO. REP. HA