

**SURVEY &
REMONUMENTATION**

RECORDED
WASHTENAW COUNTY, MI

MAY - 1 1995

COPY

FEB 1 9 00 AM '95

COMMISSION

LAND CORNER RECORDATION CERTIFICATE
Filing Requirement of Act 74, Mich. P.A. 1970

PEGGY M. HAINES
COUNTY CLERK/REGISTER

For corners in

<u>Washtenaw</u> (County)	Located In:	Corner Code #
1. Public Land Survey	T <u>4S</u> R <u>7E</u>	<u>L-9</u>
	T _____ R _____	_____
	T _____ R _____	_____
	T _____ R _____	_____
2. Property Controlling in Section	S _____ T _____ R _____	_____
	S _____ T _____ R _____	_____
3. Miscellaneous Property in Sec.	S _____ T _____ R _____	_____
	S _____ T _____ R _____	_____

-COPY-

LIBER **1 PAGE 394 RM**
COPY
Register of Deeds Stamp & File Number

4. Lot No. _____, Recorded Plat _____
5. Private Claims _____

	A	B	C	D	E	F	G	H	I	J	K	L	M
2	6	5	4	3	2	1							
3													
4	7	8	9	10	11	12							
5													
6	18	17	16	15	14	13							
7													
8	19	20	21	22	23	24							
9													
10	30	29	28	27	26	25							
11													
12	31	32	33	34	35	36							
13													

Thomas L. Sutherland in a field survey on November 15, 19 94, do hereby certify that under requirements of P.A. 74, Michigan P.A. of 1970, the corner points mentioned in lines 1 and 2 above were in conformance with regulations and rules therelore as required in the current manual of survey instructions of the United States Department of the Interior, Bureau of Land Management or by a decree of a Court of Law and/or that the corner points mentioned in lines 3, 4 and 5 above were in conformance with the rules of the Michigan Board of Land Surveyors or by a Decree of a Court of Law; established, re-established, monumented, re-monumented, recovered, found as expressed below:

NOTE: Not more than 4 corners, all in the same town and range, may be recorded on this certificate.

A. Description of original monument and accessories and/or subsequent restoration:

(W.C.R.C. 1930)
Bar monumented with
Stones and Bricks

(Midwestern Consulting 1972)
3/4" Iron
PA 74 L.C.R.C.
Liber 2, Page 317

(Washtenaw Engineering 1990)
3/4" Iron Pipe
Power Pole N33°E 62.19
Power Pole S23°E 79.84
17" Red Oak S41°W 35.56
Easterly 12" Red Oak of Clump
N12°W 92.76

(Glen Richard #13040 1972)
3/4" Iron Pipe
PA 74 L.C.R.C.
Liber 2, Page 79

(Atwell-Hicks 1973)
1/2" Iron Pipe
PA 74 L.C.R.C.
Liber 2, Page 575

B. Description of corner evidence found and/or method applied in restoring or reestablishing corner:

Found 3/4" Iron Pipe at asphalt surface over a 1/2" pinched top iron pipe 18" below asphalt surface. The 1/2" iron pipe was over a 1" iron pipe 24" below asphalt surface surrounded by bricks. Raised 1/2" iron pipe with a 3/4" iron pipe with aluminum Washtenaw County Remonumentation Cap. Set Monument Box over pipe.

APPROVED


DATE 11/21/94
CO. REP. ES

C. Description of monument for corner and accessories established to perpetuate locating the position of the corner:

1" Iron Pipe with Aluminum Washtenaw County Remonumentation Cap in Monument Box
Power Pole N35°E 62.26 to Nail W/W.C.R. Tag in SE Side
Power Pole S30°E 79.85 to Nail W/W.C.R. Tag in S.W. Side
2 1/2" Iron Pipe SOUTH 33.24
20" Oak S40°W 36.00 to Nail Triple 12" Box Elder N45°W 51.32 to Nail W/W.C.R. Tag in S.W. Side

I conclude that after careful study of the record documentation and field observation, that this corner is accepted as the best available evidence of the position of the original corner.

Signed by Thomas L. Sutherland
Surveyor's Michigan License No. #24620

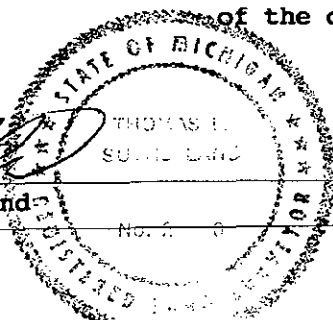

Date December 14, 1994