

**SURVEY &
REMONUMENTATION**

MAY - 1 1995

COMMISSION

COPY

RECORDED
WASHTENAW COUNTY, MI

FEB 19 01 AM '95

LAND CORNER RECORDATION CERTIFICATE
Filing Requirement of Act 74, Mich. P.A. 1970

For corners in

Washtenaw

(County)

Located In:

Corner Code #

1. Public Land Survey	T	<u>4S</u>	R	<u>7E</u>	<u>L-13</u>
	T		R		
	T		R		
	T		R		
2. Property Controlling in Section	S		T		R
	S		T		R
3. Miscellaneous Property in Sec.	S		T		R
	S		T		R

PEGGY H. HAINES
COUNTY CLERK/REGISTER

- COPY -

LIBER 1 PAGE 396 RM
COPY

Register of Deeds Stamp & File Number

4. Lot No. _____, Recorded Plat _____
5. Private Claims _____

	A	B	C	D	E	F	G	H	I	J	K	L	M
2	6		5		4		3		2		1		
3													
4	7		8		9		10		11		12		
5													
6	18		17		16		15		14		13		
7													
8	19		20		21		22		23		24		
9													
10	30		29		28		27		26		25		
11													
12	31		32		33		34		35		36		
13													

Thomas L. Sutherland in a field survey on November 15, 19 94, do hereby certify that under requirements of P.A. 74, Michigan P.A. of 1970, the corner points mentioned in lines 1 and 2 above were in conformance with regulations and rules therefore as required in the current manual of survey instructions of the United States Department of the Interior, Bureau of Land Management or by a decree of a Court of Law and/or that the corner points mentioned in lines 3, 4 and 5 above were in conformance with the rules of the Michigan Board of Land Surveyors or by a Decree of a Court of Law; established, re-established, monumented, re-monumented, recovered, found as expressed below:

NOTE: Not more than 4 corners, all in the same town and range, may be recorded on this certificate.

A. Description of original monument and accessories and/or subsequent restoration:

(W.C.R.C. 1935)

Found a wood stake and stones.
Re-set by driving an Iron Pipe into the stake and put broken brick around it. Put the stone on top of the pipe and set bricks around it.

B. Description of corner evidence found and/or method applied in restoring or reestablishing corner:

Found 1 1/2" Iron Pipe and Bricks 24" below gravel surface. Raised with 3/4" Iron Pipe with Aluminum Washtenaw County Remonumentation Cap to 6" below gravel surface.

C. Description of monument for corner and accessories established to perpetuate locating the position of the corner:

3/4" Iron Pipe with Aluminum Washtenaw County Remonumentation Cap
Twin 18" Oak N15°W 79.92 to Nail W/W.C.R. Tag in E. Side
14" Ash N25°W 33.06 to Nail W/W.C.R. Tag in E. Side
1/2" Iron Rod N35°W 1.36 Top of Guy Anchor N80°E 30.41 Center of Concrete R.O.W. Marker N88°W 33.25+
4" Ash S40°E 33.92 to Nail W/W.C.R. Tag in SW Side
20" Poplar S40°W 50.55 to Nail W/W.C.R. Tag in SE Side


I conclude that after careful study of the record documentation and field observations, that this corner is accepted as the best available evidence of the position of the original corner.

APPROVED

DATE 11/28/94

CO. REP. K

Signed by Thomas L. Sutherland
Surveyor's Michigan License No. #24520

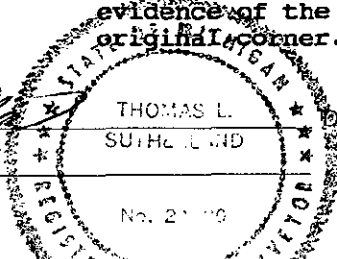

Date December 14, 1994